


DATE _____

TOWN OF LEXINGTON — BOARD OF PUBLIC WORKS
WATER DIVISION

alg

Sketch of Service Here

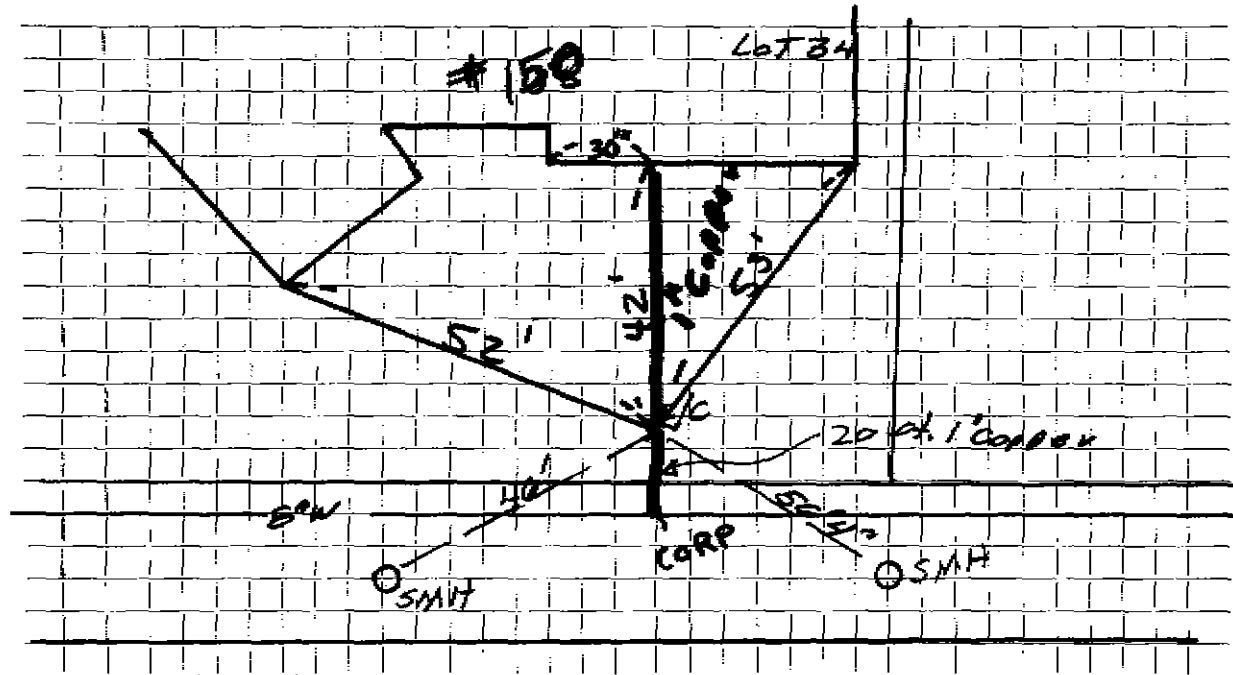

Connection made in 150 East Emerson Rd. Street. Work completed

Remarks:

.....

.....