




DATE MARCH 15, 1985

TOWN OF LEXINGTON — BOARD OF PUBLIC WORKS

WATER DIVISION

Sketch of Service Here

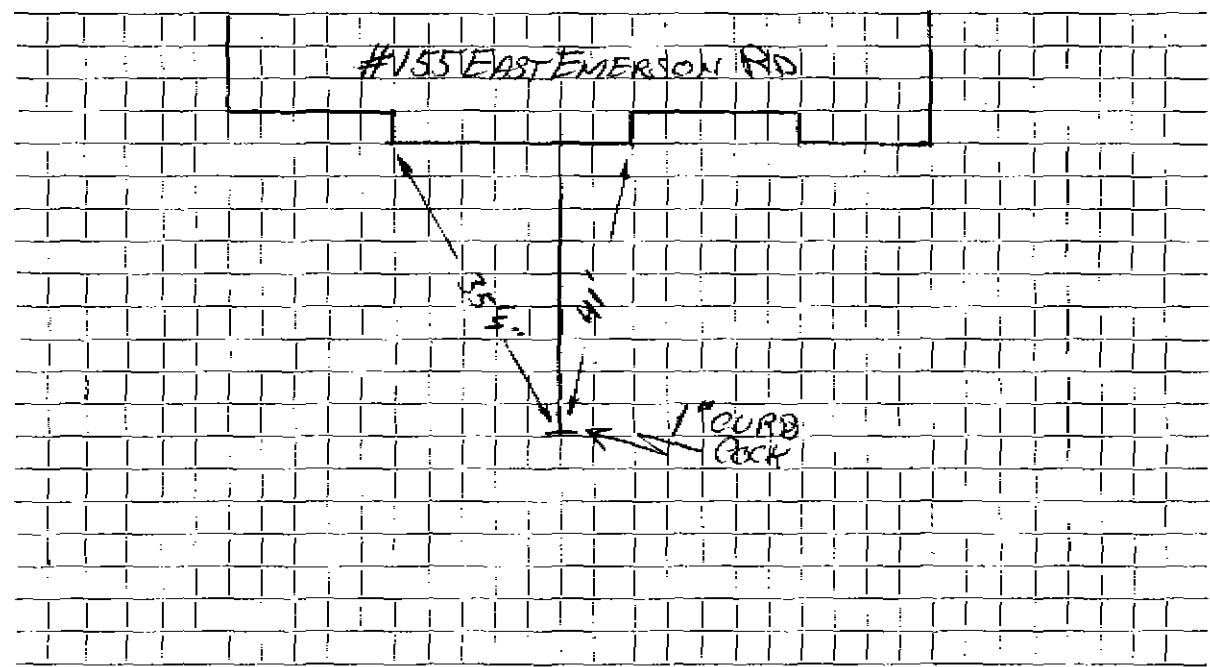

Connection made in EAST EMERSON ROAD Street.

Work completed MARCH 1985

Remarks: .....

.....

.....