

WATER SERVICE RECORD

Name Prescott Realty

Service No.

Address 156 EAST EMERSON

Location

Repair ~~Renewal~~ - New Service Arlex #3977


Date	Material	Amount	Total	Date	Amount
6-11 85	INSIDE				OUTSIDE
	34' 1" COPPER				1 1" CURB
	1 1" WHEEL HANDLE				1 1" CORR.
					1 BOX + ROD
					<del>2 1" COPPER</del>
	10' AT FOUNDATION				16 1" Copper

DATE \_\_\_\_\_

TOWN OF LEXINGTON — BOARD OF PUBLIC WORKS

**WATER DIVISION**

Sketch of Service Here

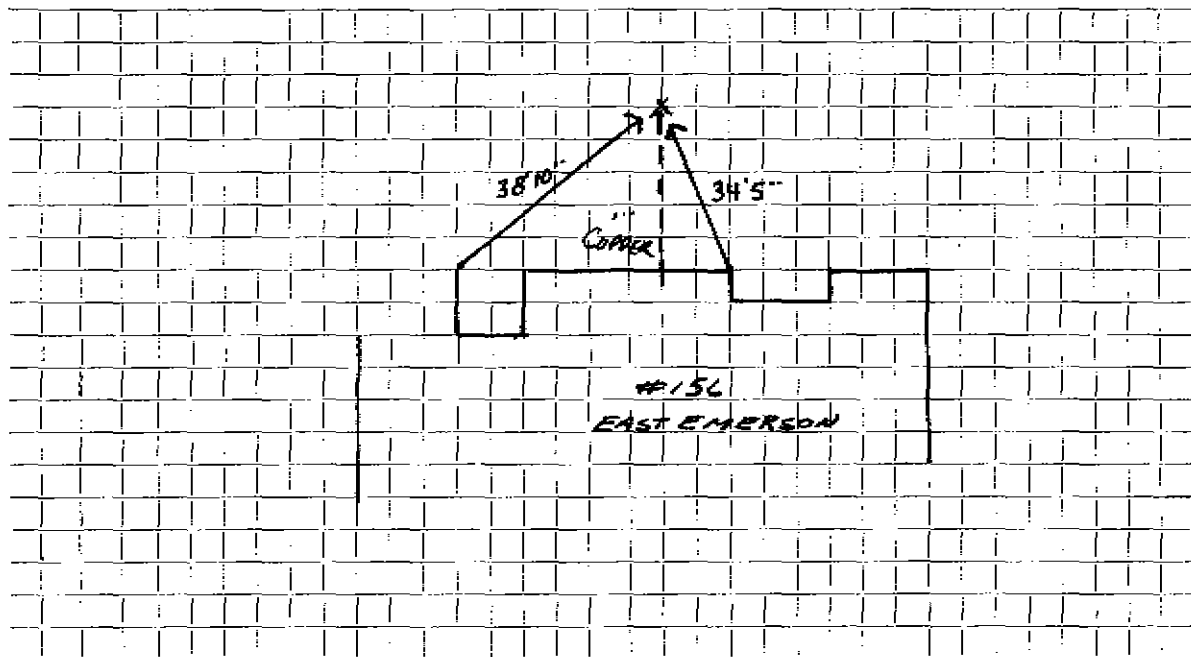

Connection made in ..... Street. Work completed .....

Remarks: .....  
.....  
.....