

WATER SERVICE RECORD

Name Prescott Village Realty Trust

Service No.

Address 161 EAST EMERSON

Location


~~Repair/Rehook~~ - New Service Arlex #3976

Date	Material	Amount	Total	Date	Amount
6-11-85	INSIDE				OUTSIDE
	43.5' 1" COPPER				1 1" CURB
	1 1" WHEEL HANDLE				1 1" CURB
					1 BOX + ROD
					2' 1" COPPER
					30' 1" Copper
	9' DEEP AT FOUNDATION				

DATE _____

TOWN OF LEXINGTON — BOARD OF PUBLIC WORKS
WATER DIVISION

Sketch of Service Here

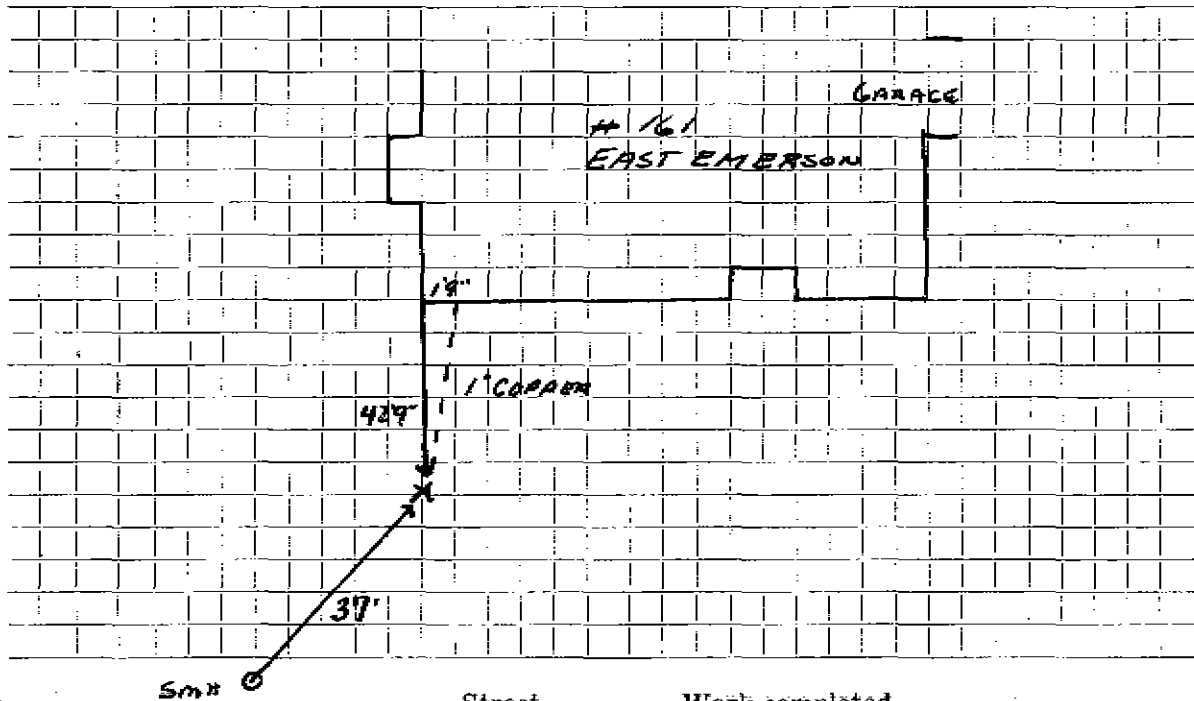

Connection made in SM Street. Work completed

Remarks:
.....
.....