

WATER SERVICE RECORD

Name Prescott Village Realty Trust

Service No.

Address 164 East Emerson Road

Location Lot #36

Repair ~~Renewal~~ New Service Arlex #36


Date	Material	Amount	Total	Date	Amount
------	----------	--------	-------	------	--------

3/14/85	60' x 1" Copper Tubing				
	1 1" R.H. Wheel Valve				

DATE MARCH 14, 1985

TOWN OF LEXINGTON — BOARD OF PUBLIC WORKS
WATER DIVISION

Sketch of Service Here

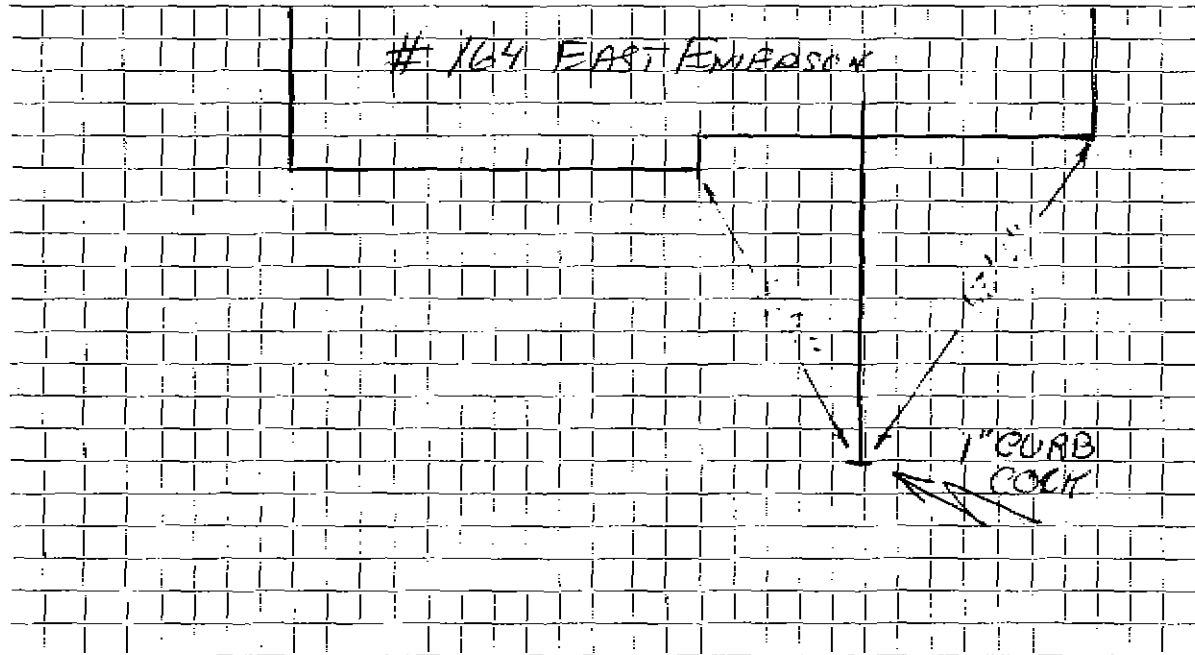

Connection made in EAST EMERSON RD Street.

Work completed MARCH 1985

Remarks:

.....

.....