## WATER SERVICE RECORD

Name Prescott Village Realty Trust

Service No.


<del></del>	lress ation	171 East Street						
		Lot #16 Senewal New Service	lex #4002					
Date	,	Material	Amount	Total	Date			Amount
3/14/85	47'	x 1" Copper tubing						
	1	1" R.H. Wheel Valve				36 /	Copper	<del></del>
<u> </u>						<del>-</del>	<del></del>	
<del></del>		·			_ <del></del>	<u></u>	<del></del>	
				i	- <del> </del>	+		
	·				1! 			
		<u> </u>	:	! 	<del> </del>	<del></del>		
<u> </u>	<u> </u>	ļ		 		+-+-	·	<del>-</del>
			<u>-</u>	<u> </u>		<u> </u>		·
	<del></del>			·	<del>-  </del>	· · ·		
		·	· · · · · · · · · · · · · · · · · · ·				· · · · · · · · · · · · · · · · · · ·	
	<u> </u>	<u> </u>		· - <del>-</del>	·	<u> </u>		<u> </u>
		·		<del> </del>	- !	! !		
		:	<del></del>	<del></del>	ji	<u> </u>	·	
- · <del></del>	<u> </u>				!:	<del> </del>		- ··· †··
	<del></del>			i ————————————————————————————————————	-	<del></del>		<del></del>

TAC	E	 	_	

## TOWN OF LEXINGTON - BOARD OF PUBLIC WORKS

## WATER DIVISION

## Sketch of Service Here

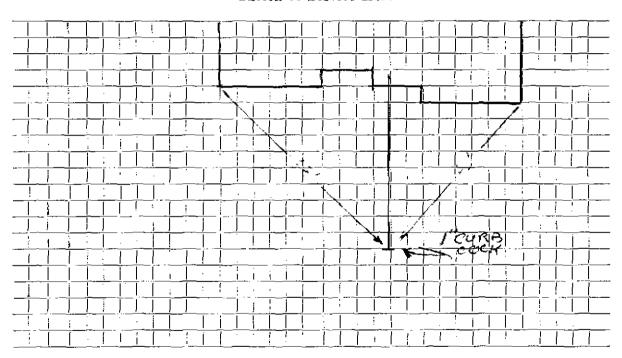

Connection made in Street.	Work completed
Remarks:	
.,	