




DATE \_\_\_\_\_

TOWN OF LEXINGTON — BOARD OF PUBLIC WORKS

**WATER DIVISION**

Sketch of Service Here

Lot 39

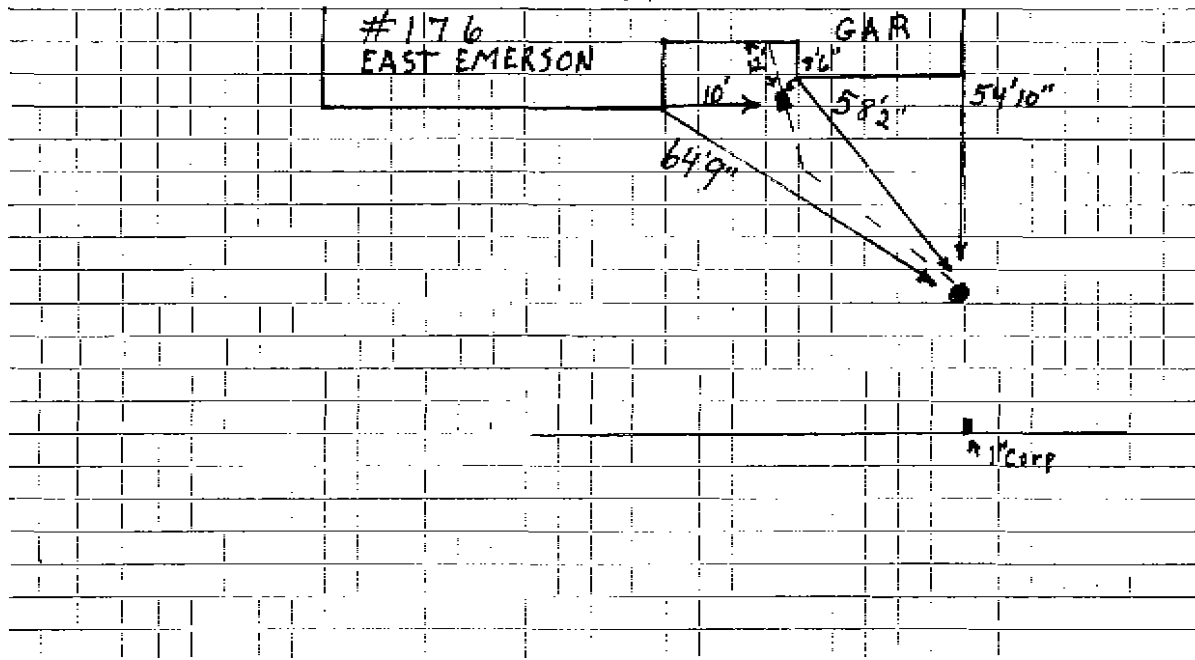

Connection made in ..... Street. Work completed .....

Remarks: *WATER IS 1 1/2' TO 2' ABOVE SEWER SINE TRENCH* .....

.....  
.....