




DATE July 1983

TOWN OF LEXINGTON — BOARD OF PUBLIC WORKS  
WATER DIVISION

Sketch of Service Here

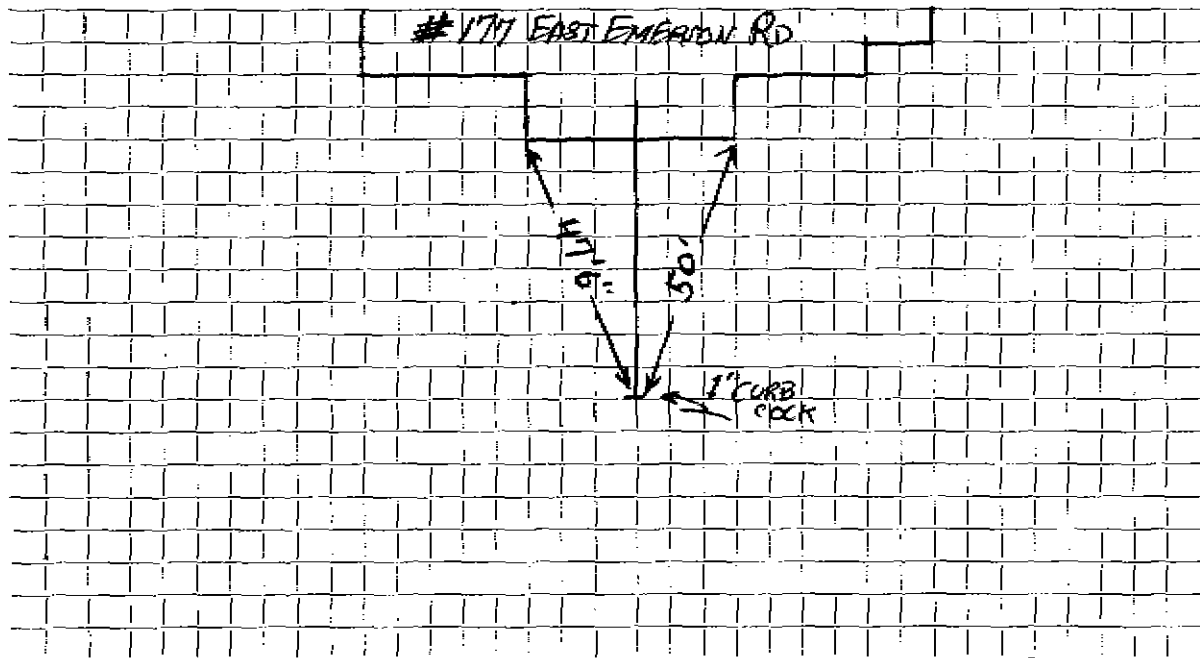

Connection made in FAST EMERSON RD Street. Work completed July 12, 1983.

Remarks: NO OUTSIDE INFORMATION