

WATER SERVICE RECORD

Name Prescott Village Realty Trust

Service No.

Address 184 East Emerson Road

Location Lot #41

~~Repair/Renewal~~—New Service Arlex #4001


Date	Material	Amount	Total	Date	Amount
3/12/85	45'	6" of 1" Copper tubing			
	1	1" Curb Cock & Box & Rod			
		1" Wheel Handle			

DATE \_\_\_\_\_

TOWN OF LEXINGTON — BOARD OF PUBLIC WORKS

WATER DIVISION

Sketch of Service Here

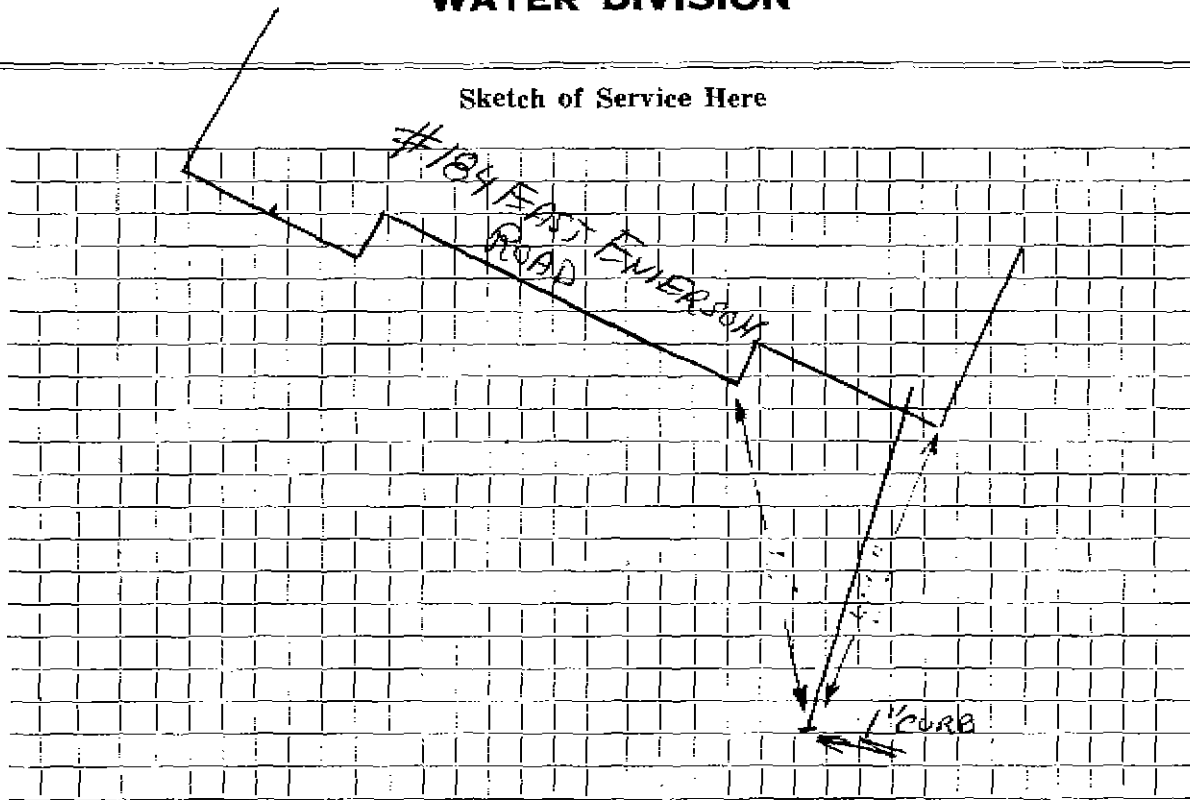

Connection made in ..... Street.

Work completed MARCH 1985

Remarks: .....