




DATE MAY 16, 1983

TOWN OF LEXINGTON — BOARD OF PUBLIC WORKS

WATER DIVISION

Sketch of Service Here

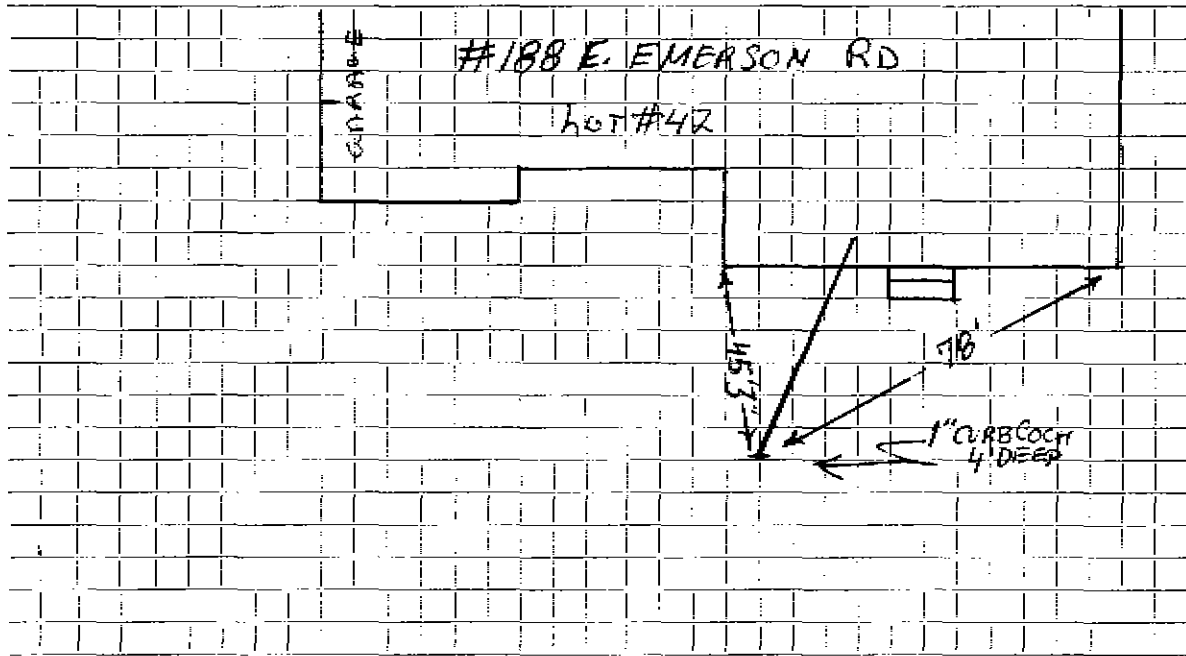

Connection made in E. EMERSON RD Street. Work completed MAY 1983

Remarks: NO OUTSIDE INFORMATION