


DATE _____

TOWN OF LEXINGTON — BOARD OF PUBLIC WORKS

WATER DIVISION

Sketch of Service Here

196 EAST EMERSON

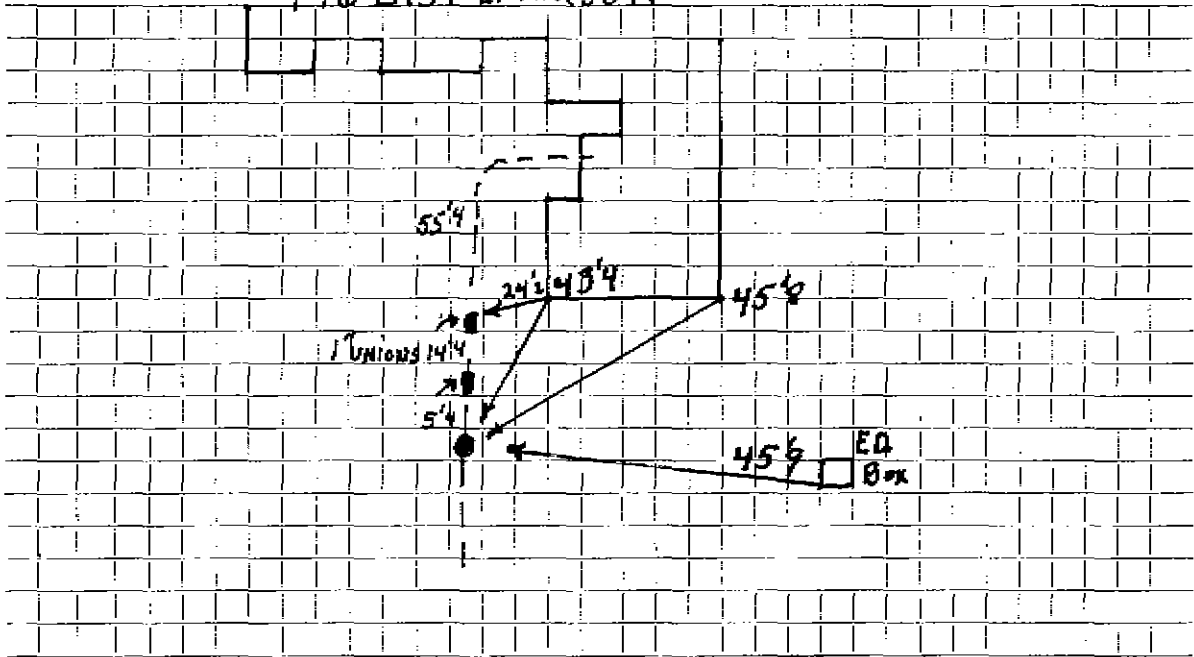

Connection made in Street. Work completed

Remarks: See Insp. File for UNIONS