

WATER SERVICE RECORD

Name *Prescott Village Realty Trust*

Service No.

Address *199 East Emerson Road*

Location


~~Repair/Removal~~ *New Service Eagle #4475*

Date	Material	Amount	Total	Date	Amount
<i>6/28/84</i>	<i>47' 1" Copper Tubing</i>				
	<i>1 1" Union</i>				
	<i>1 1" Valve</i>				
					<i>OUTSIDE</i>
				<i>6/28/84</i>	<i>1" Copper</i>
				<i>1</i>	<i>1" Corporation</i>
				<i>1</i>	<i>1" Curb No Waste</i>
				<i>1</i>	<i>Box & Rod</i>

DATE _____

TOWN OF LEXINGTON — BOARD OF PUBLIC WORKS
WATER DIVISION

Sketch of Service Here

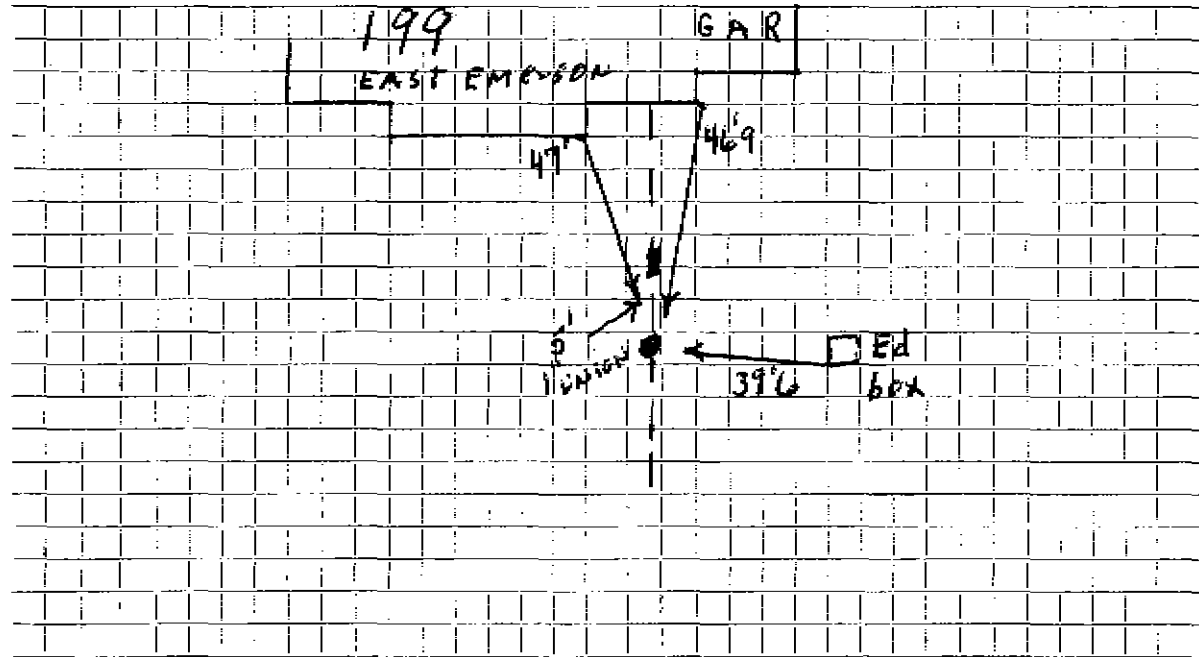

Connection made in Street. Work completed

Remarks:
.....
.....