


CRG

DATE _____

TOWN OF LEXINGTON — BOARD OF PUBLIC WORKS

WATER DIVISION

Sketch of Service Here

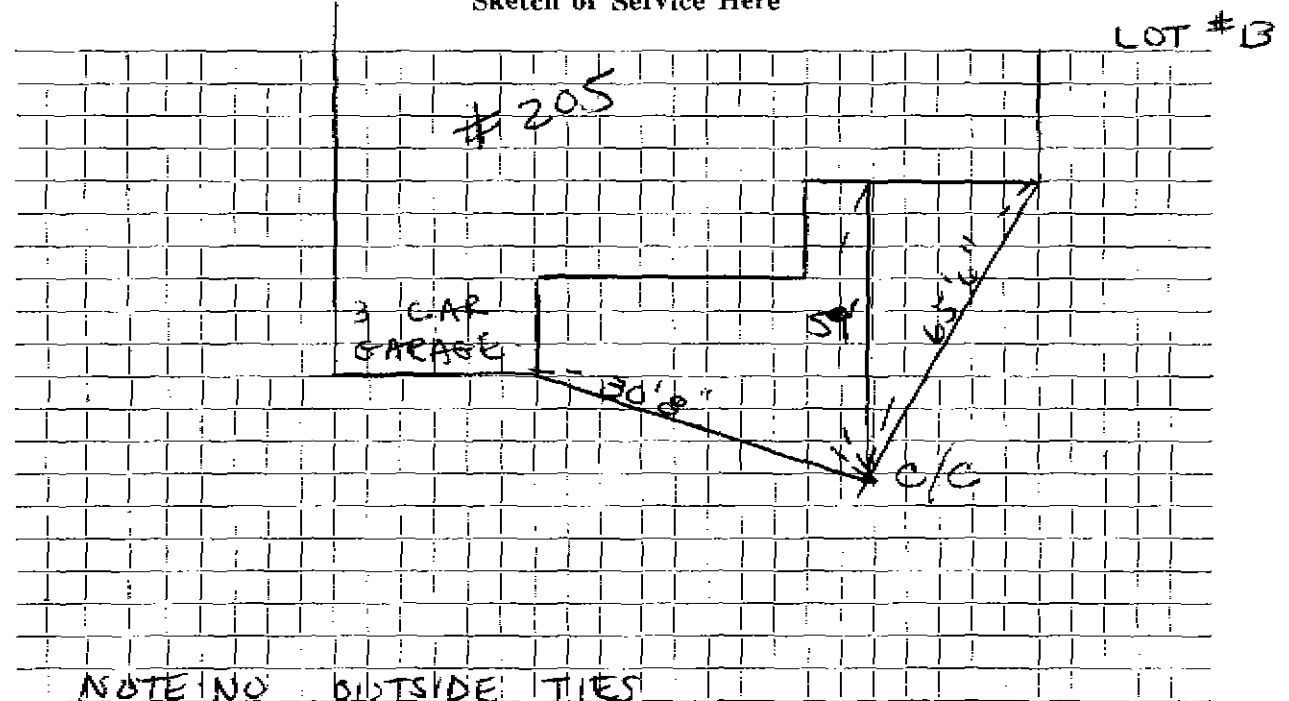

NOTE NO OUTSIDE TIES

Connection made in EAST EMERSON Street. Work completed

Remarks:
.....
.....