

WATER SERVICE RECORD

Name Prescott Village Realty

Service No.

Address 209 East Emerson Road

Location


~~Repair~~ ~~Renewal~~ - New Service Arlex 3978

Date	Material	Amount	Total	Date	Amount
6/17/85	55' 1" Copper tubing				
	1 1" Union				
	1 1" Valve				
					OUTSIDE
				6/17/85	1" Copper
					1" Corp
					1" Curb
					Box & Rod

DATE _____

TOWN OF LEXINGTON — BOARD OF PUBLIC WORKS
WATER DIVISION

Sketch of Service Here

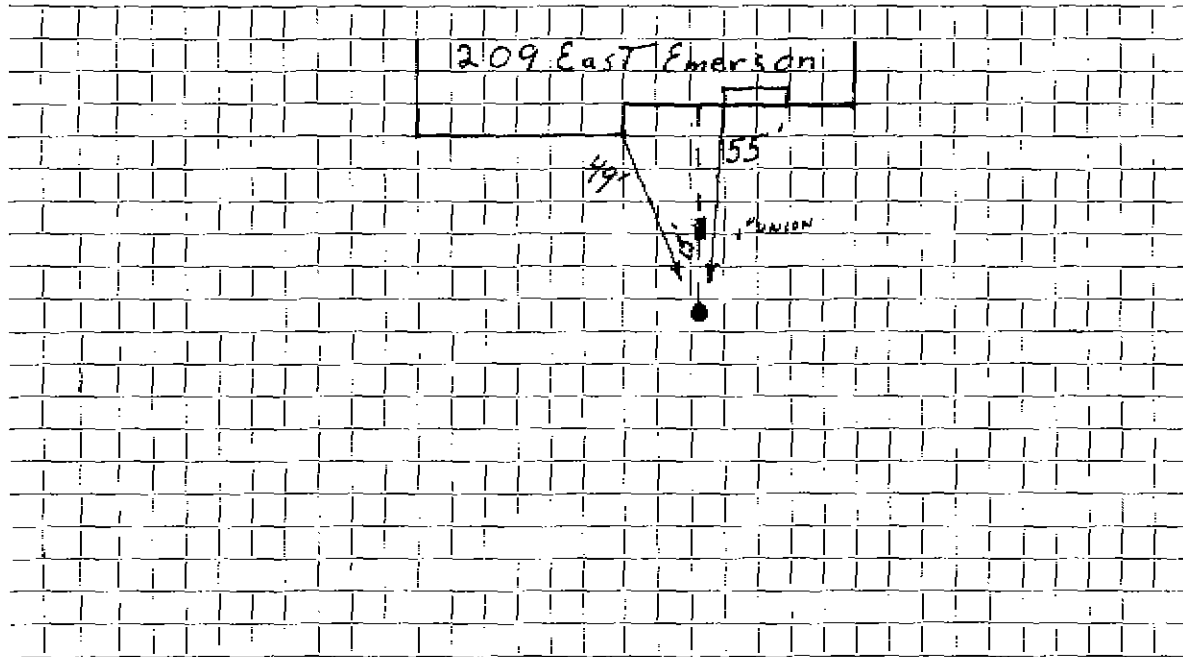

Connection made in Street. Work completed

Remarks:
.....
.....