




DATE \_\_\_\_\_

TOWN OF LEXINGTON — BOARD OF PUBLIC WORKS

WATER DIVISION

Sketch of Service Here

LOT //

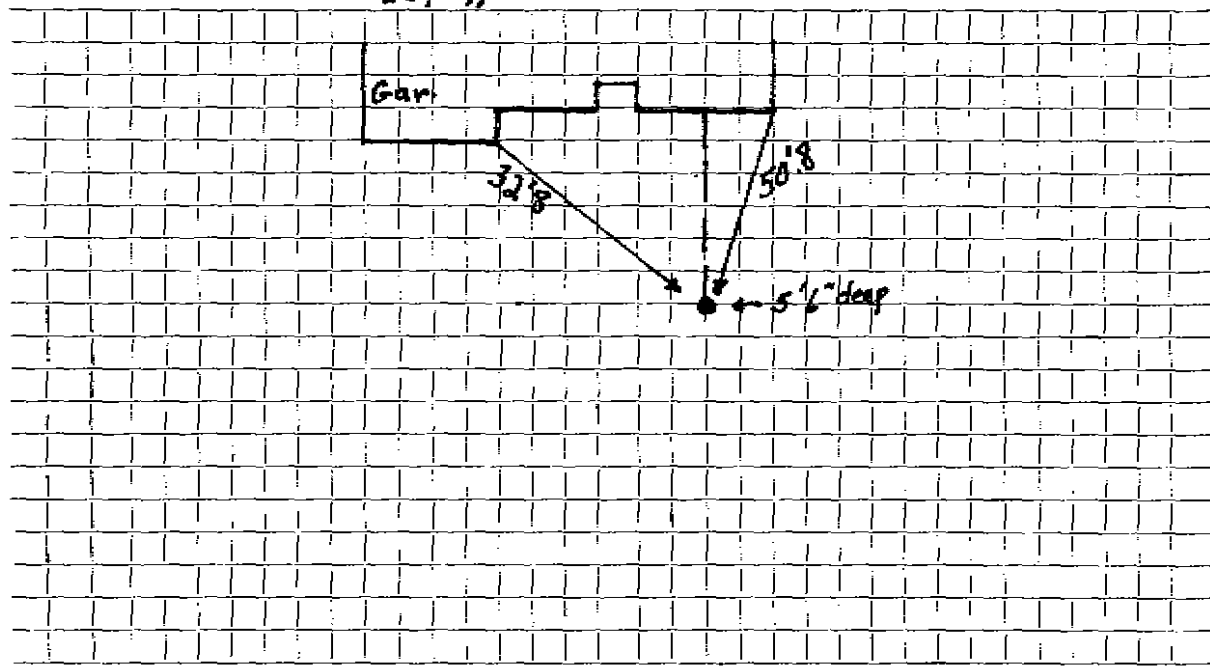

Connection made in ..... Street. Work completed .....

Remarks: 211 East Emerson? .....