


DATE 12-23-82

TOWN OF LEXINGTON — BOARD OF PUBLIC WORKS

WATER DIVISION

Sketch of Service Here

Lot #1

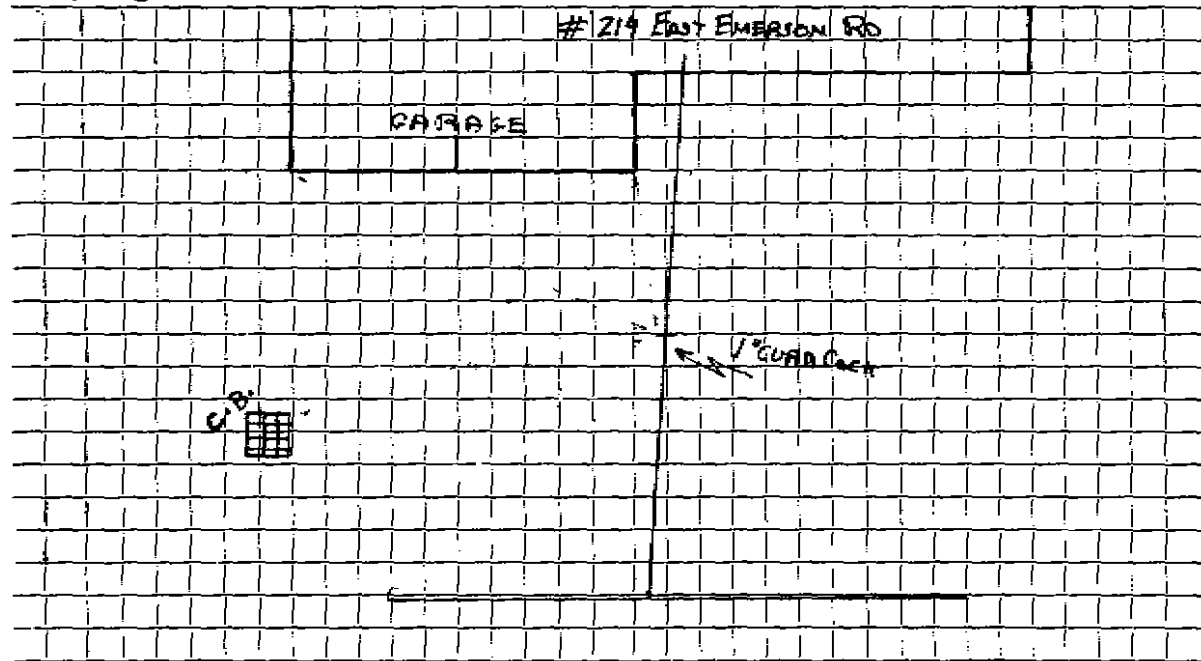

Connection made in EAST EMERSON RD Street. Work completed 11-82

Remarks:

.....

.....