


DATE 1982

TOWN OF LEXINGTON — BOARD OF PUBLIC WORKS
WATER DIVISION

Sketch of Service Here

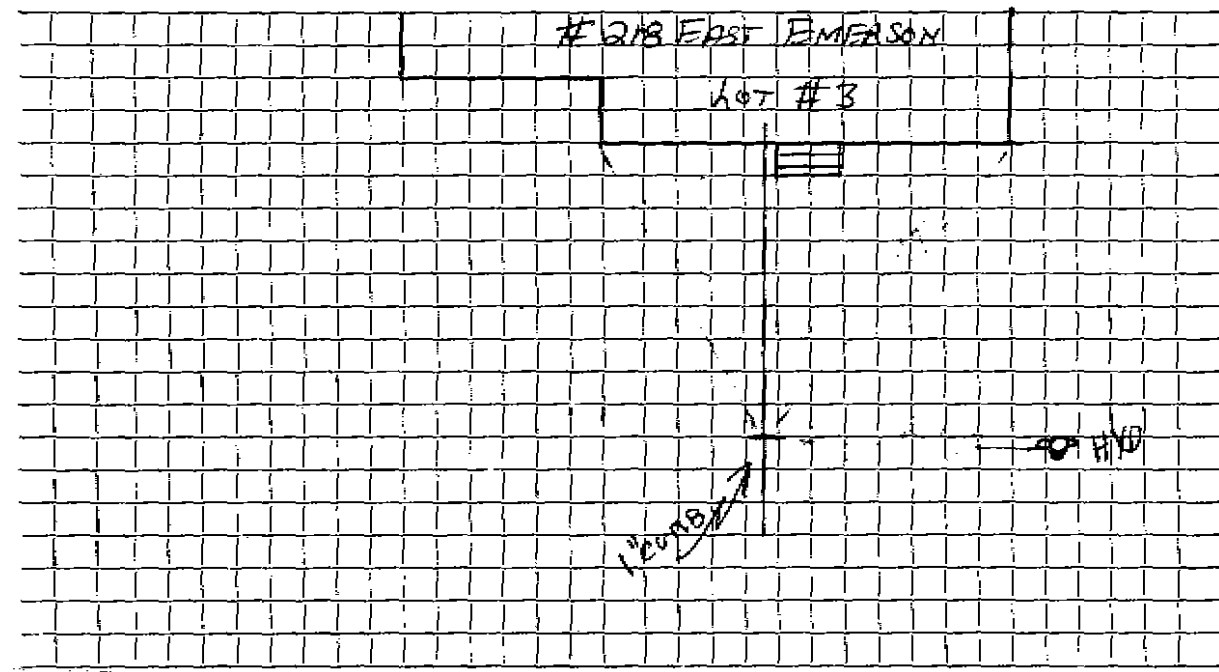

Connection made in EAST EMERSON RD Street.

Work completed OCT. 14, 1983

Remarks: