


DATE _____

TOWN OF LEXINGTON — BOARD OF PUBLIC WORKS
WATER DIVISION

Sketch of Service Here

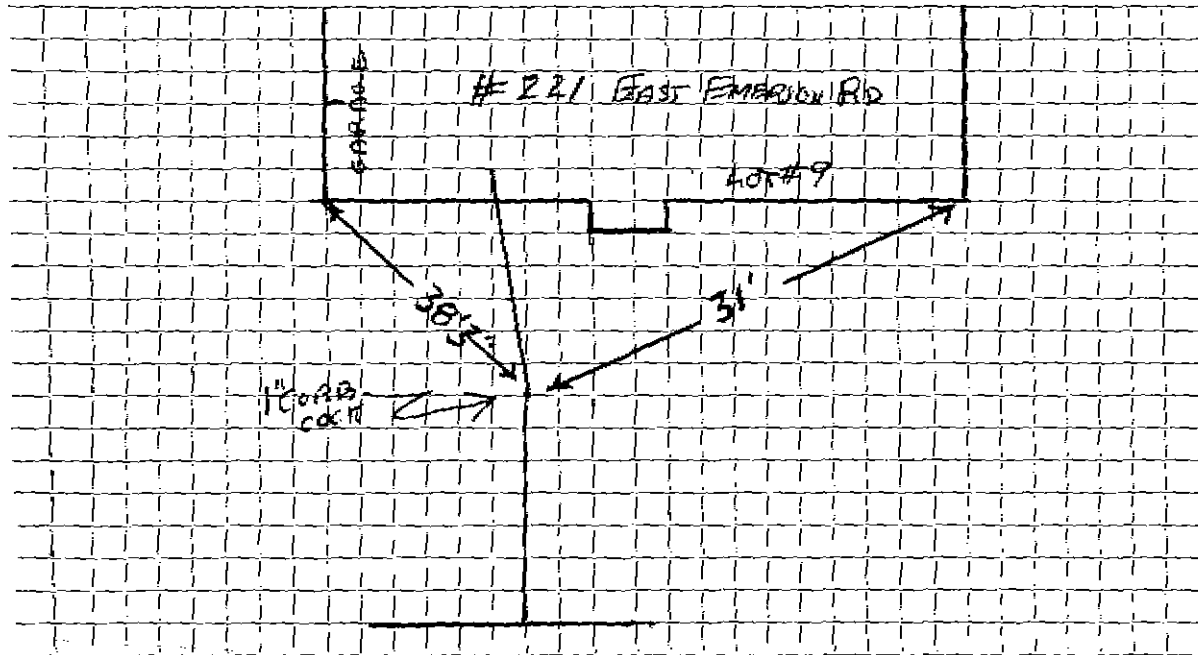

Connection made in EAST EMERSON Street. Work completed NOVEMBER 1982

Remarks: NO OUTSIDE MEASUREMENT