

## **WATER SERVICE RECORD**

Name    Prescott Village Realty Trust

**Service No.**

Address Lot #7<sup>231</sup> EAST EMERSON


### **Location**

~~Repair Department~~-New Service John P. DiTonno Arlex #3744

DATE \_\_\_\_\_

TOWN OF LEXINGTON — BOARD OF PUBLIC WORKS  
WATER DIVISION

Sketch of Service Here

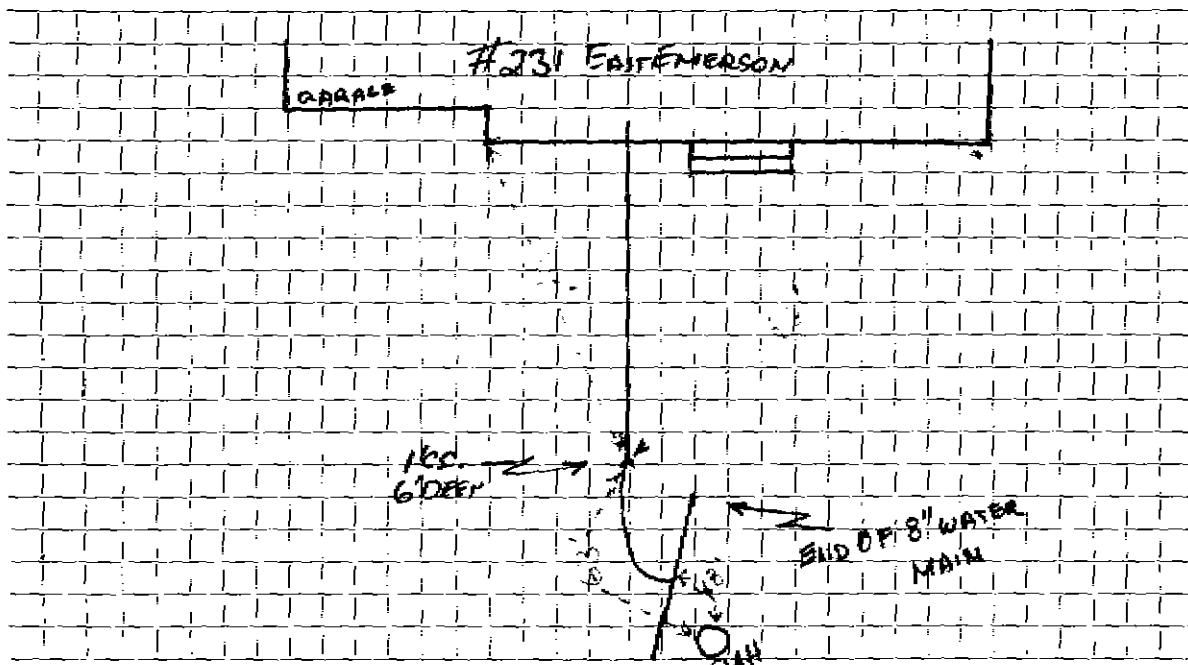

Connection made in ..... Street. Work completed .....

Remarks: .....