

WATER SERVICE RECORD

Name Prescott Realty Trust

Service No.

Address 237 East Emerson Road

Location Lot #6

~~Repair Request~~ New Service Arlex #3734

Date	Material	Amount	Total	Date	Material	Amount
7/1/82	40' 1" Copper tubing					
					OUTSIDE	
				11/4/81	57' 1" Copper tubing	
					1 1" Corp.	
					1 1" Curb Cock	
					1 Box & Rod	


DATE _____

TOWN OF LEXINGTON — BOARD OF PUBLIC WORKS

WATER DIVISION

Sketch of Service Here

237 East EMERSON RD

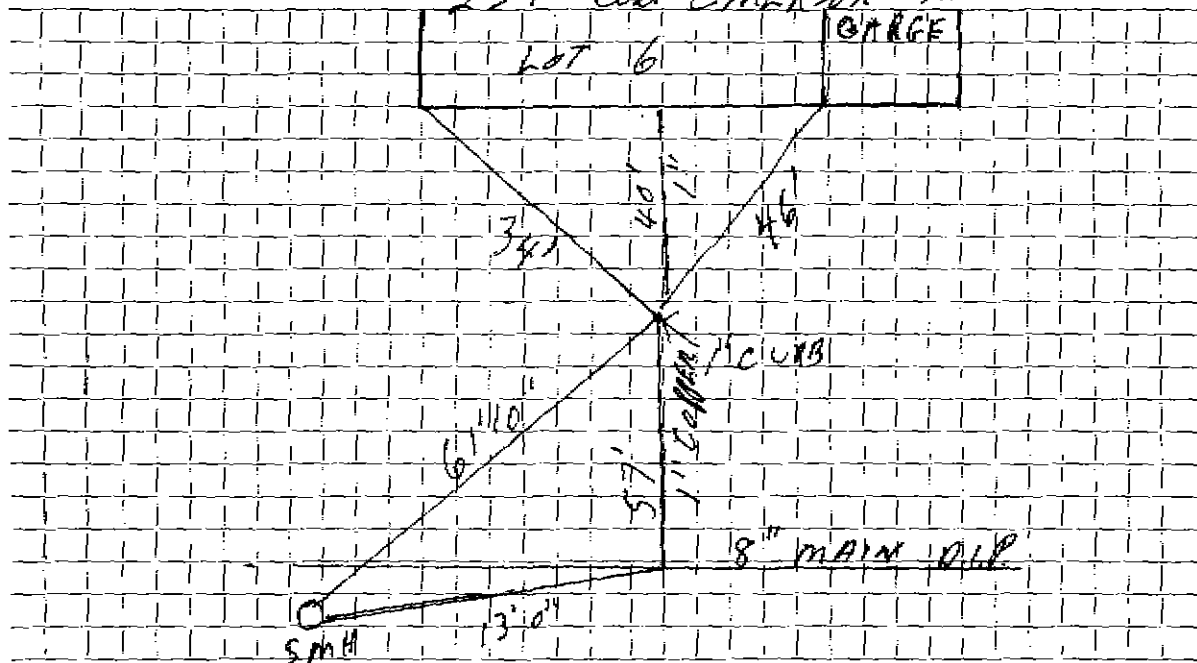

Connection made in Street. Work completed :

Remarks:

.....

.....