


DATE 12-23-82

TOWN OF LEXINGTON — BOARD OF PUBLIC WORKS
WATER DIVISION

Sketch of Service Here

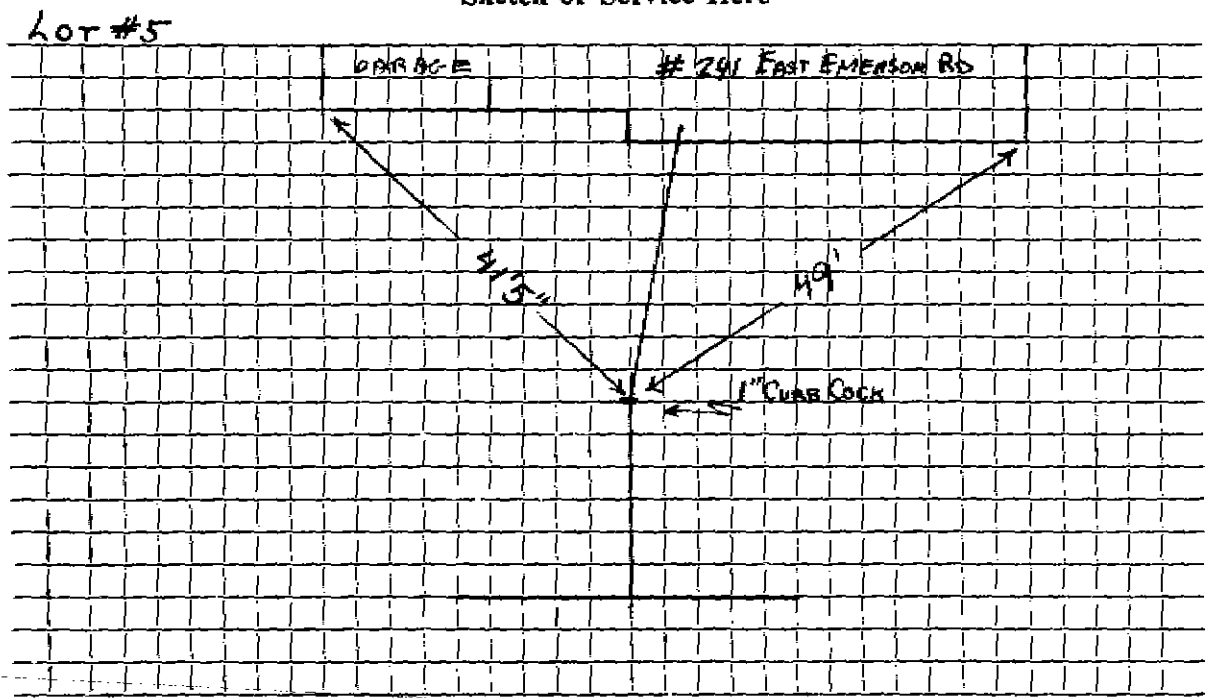

Connection made in EAST EMERSON RD Street. Work completed NOVEMBER 1982

Remarks:

.....

.....