




DATE \_\_\_\_\_

TOWN OF LEXINGTON -- BOARD OF PUBLIC WORKS

WATER DIVISION

MAUREEN  
RD.

Sketch of Service Here

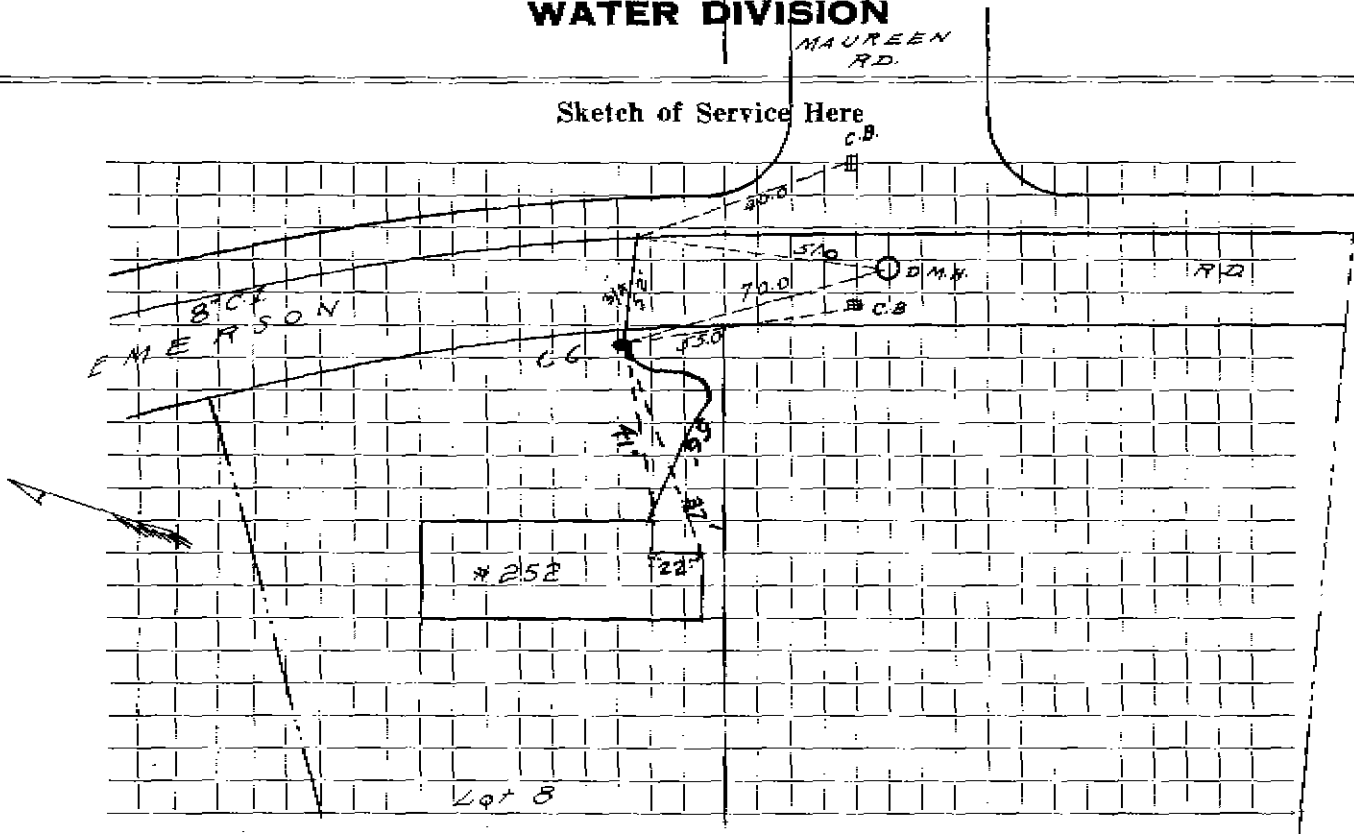

Connection made in ..... Street. Work completed .....

Remarks: .....

.....

.....