

WATER SERVICE RECORD

Name

Service No.

Address 120 EAST ST

Location LOT

Repair—Renewal—New Service


Date	Material	Amount	Total	Date	Amount
	CURB TIE ON BACK				
	3/4 COPPER				
	3/4 CORP				
	3/4 CURB STOP				
	BOX + ROD				
	TOTAL	\$1.00	(Bk) 7/16/50		

DATE _____

TOWN OF LEXINGTON — BOARD OF PUBLIC WORKS

WATER DIVISION

Sketch of Service Here

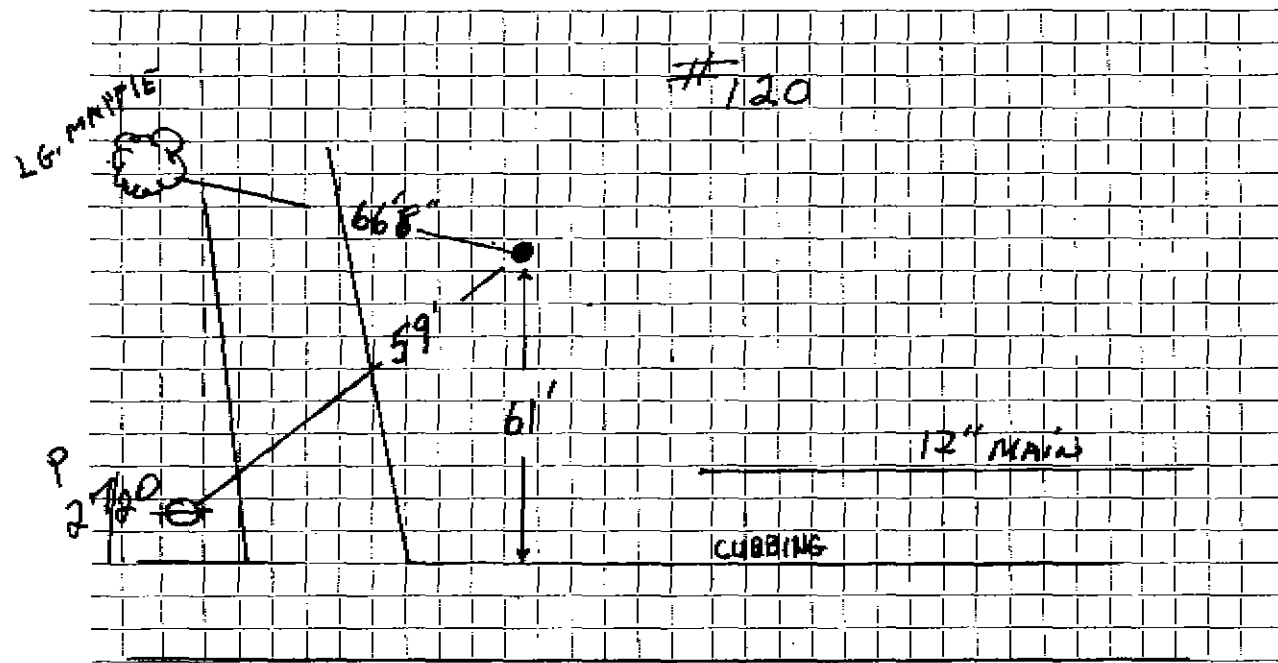

Connection made in Street. Work completed

Remarks: SERVICE INTO LOT
.....
.....