

## WATER SERVICE RECORD

Name Moore Homes

Service No. 53 N.D.

Address 135 East Street

Location Lot # #3.

Repair—Renewal—New Service W.O.#1859.

JAN 21 1980

Date	Material	Amount	Total	Date	Amount
3-11-74	Labor	<del>\$ 59.05</del>		1-21-80	
	10% O.H.	5.90	\$64.95		195.80
74'	3/4" Copper @1.05		77.70		
1	3/4 Corporation		10.50		
1	3/4 Curb		12.45		
1	3/4" 3 Part Union		4.20		
1	Box & Rod		10.00		
2	Hrs. Town Shovel @6.50		13.00		
1	Hr. Trucking		3.00		
			\$195.80		


Paid by SHP #64

DATE \_\_\_\_\_

# TOWN OF LEXINGTON — BOARD OF PUBLIC WORKS

## WATER DIVISION

Sketch of Service Here

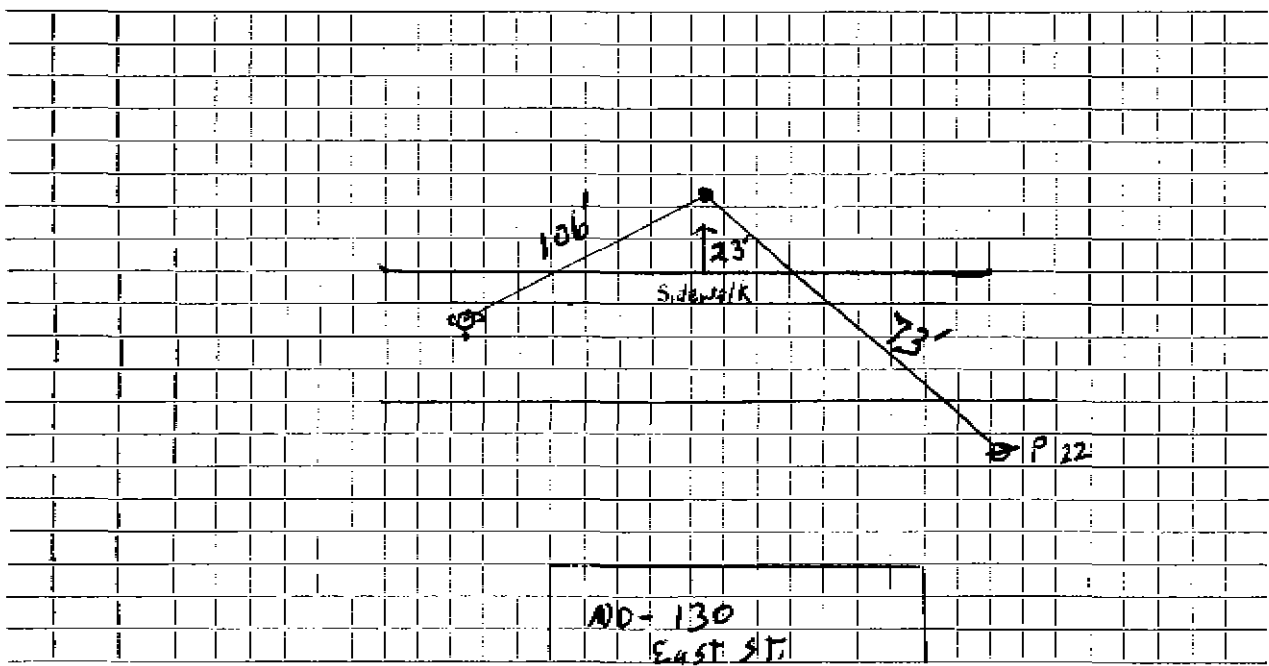

Connection made in ..... Street. Work completed .....

Remarks: .....

.....

.....