

WATER SERVICE RECORD

Name VonGormier Real Estate Dev.

Service No. 160

Address 136 East Street

Location

~~Manufacturing~~ - New Service

WO #7716

Comm 1-14-63


Date	Material	Amount	Total	Date		Amount
11-16-62	Labor	15.31		11-6-62	Deposit	100.00
	10% O.H.	1.53	16.84	1-14-63	Refund	11.52
93'	3/4" Copper tubing @.42		39.06			88.48
1	3/4" CX 1/2 I.W.H. Stop & Waste		6.17			
1	3/4" C3 Part Union		2.41		NON CHARGE	
1	Hr. Trucking @3.00		3.00	11-16-62	Labor	24.47
21	X 3 Patch		21.00	28'	3/4" Copper tubing @.42	11.76
			88.48	1	3/4" C Corp Cock	4.91
				1	3/4" C Curb Cock	6.28
				1	Box & Rod	4.90
				1	1/2 Straight tailpiece	.50
				1	1/2 Offset tailpiece	.50
				2	Hrs. Town Shovel @3.00	6.00
						59.32

DATE \_\_\_\_\_

TOWN OF LEXINGTON — BOARD OF PUBLIC WORKS

WATER DIVISION

Sketch of Service Here

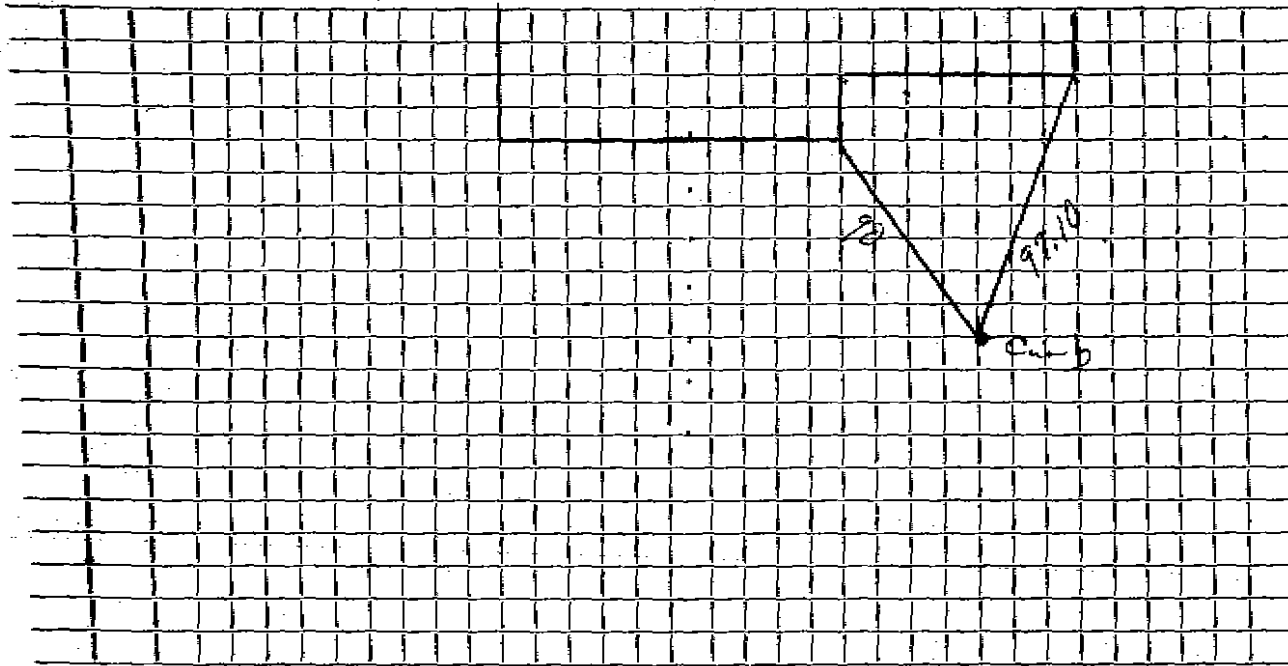

Connection made in ..... Street. Work completed .....

Remarks: .....  
.....  
.....