

WATER SERVICE RECORD

Name

Service No.

Address 14 East Street

Location

~~Work~~ - Renewal ~~Work~~ ~~Service~~


Date	Material	Amount	Total	Date	Amount
5-25-64	165'-1" Copper				
	1 1" X 1" Comp Valve				
	1 1" X 3/4" Bushing				
	3 1" - 3 Part Union				
	1 1 3/4" X 1" Mail Comp.				
				12-6-63	NON CHARGE
					Labor 20.94
					21' 3/4" Copper tubing @.42 8.82
					1 3/4" G Corp Cock 4.91
					1 3/4" Adapter 1.62
					1 hr. Town Shovel @6.50 6.50
					1 hr. Trucking @3.00 3.00
					Demi 45.79
				NOV 02 20'	1" Copper
					1" Corp
					1" Curb
					Baffle box

DATE _____

TOWN OF LEXINGTON — BOARD OF PUBLIC WORKS

WATER DIVISION

Sketch of Service Here

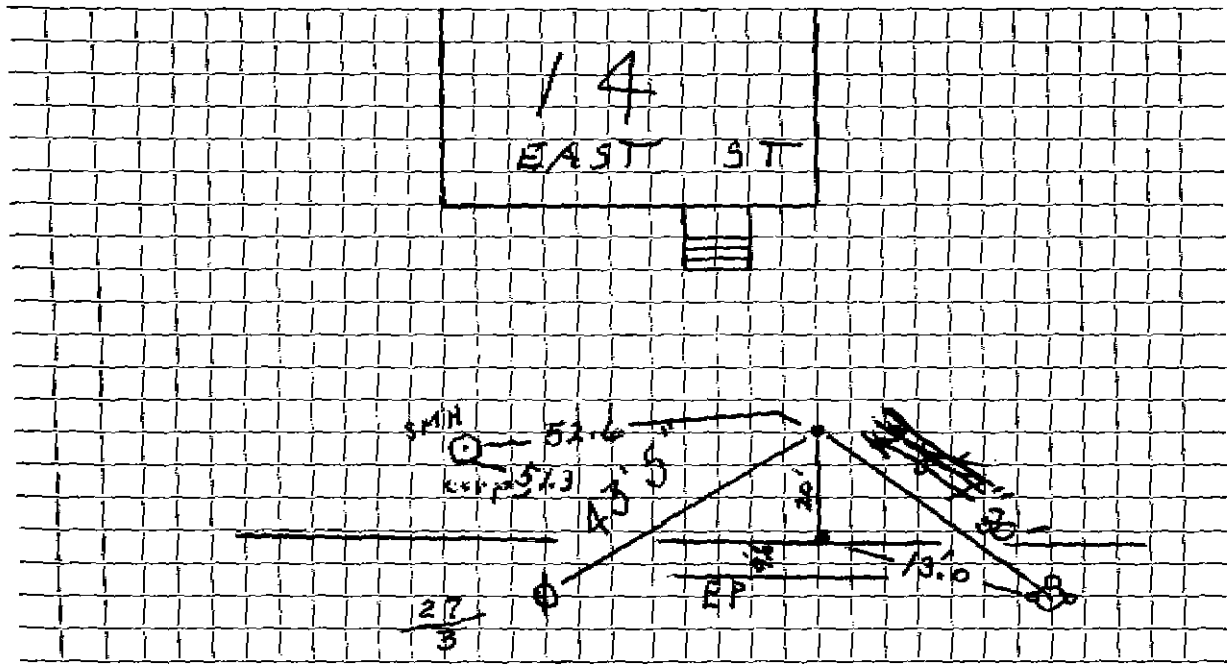

Connection made in Street. Work completed

Remarks:
.....
.....