

**WATER SERVICE RECORD**

Name Moore Homes

Service No. 47

Address 141 - 143 East Street

Location Lot #4

Repair—Renewal—New Service W.O. #908 Melone #3521


JAN 21 1980

Date	Material	Amount	Total	Date	Amount	
3-11-74	Labor	35.43		11-16-79	<i>Deposit</i>	131.00
	10% O.H.	3.54	38.97			
	41" 3/4" Copper tubing	@1.05	43.05			
	1 3/4" Corp.		10.53			
	1 3/4" Curb		12.45			
	1 Box & Rod		10.00			
	2 hrs Town Shovel @6.50		13.00			
	1 hr. Trucking		<u>3.00</u>			
			131.00			

DATE \_\_\_\_\_

TOWN OF LEXINGTON — BOARD OF PUBLIC WORKS  
WATER DIVISION

Sketch of Service Here

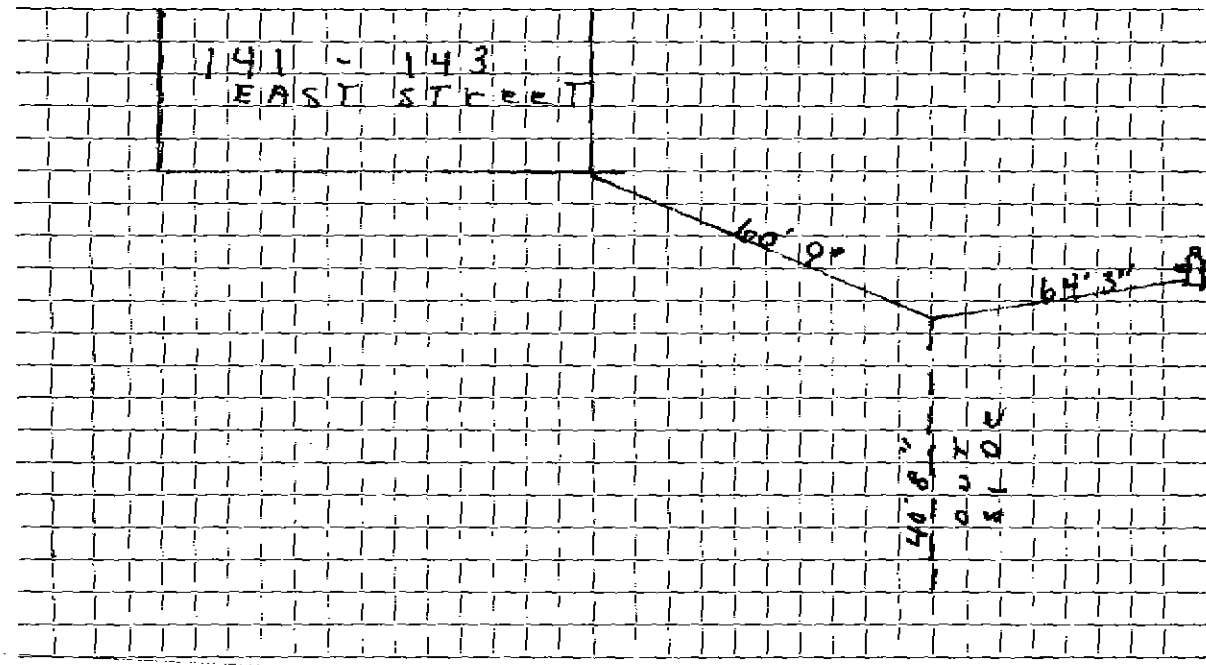

Connection made in ..... Street. Work completed .....

Remarks: .....  
.....  
.....