

WATER SERVICE RECORD

Name Moore Homes

Service No. 48

Address 145 - 147 East Street

Location

~~Repair - Renewal~~ - New Service W.O.#909 Melone #3519

JAN 21 1980

Date	Material	Amount	Total	Date	Amount
11/27/79	Labor	40.73		11-16-79	100.00
	10% C.H.	4.07	44.80	1-21-80	8.48
5'	1" Copper tubing @1.35		6.75	1-21-80	118.00
1	1" Corp		19.65		227.16
1	1" Curb		24.18		
1	Box & Rod		21.87		
1	6" x 20" Style 360 Clamp		106.91		
1	hr. Trucking @3.00		3.00		
			227.16		

Deposit
 Paid by WMC #49
 Paid by SHC #64


DATE _____

TOWN OF LEXINGTON — BOARD OF PUBLIC WORKS

WATER DIVISION

195-197 EAST ST

Sketch of Service Here

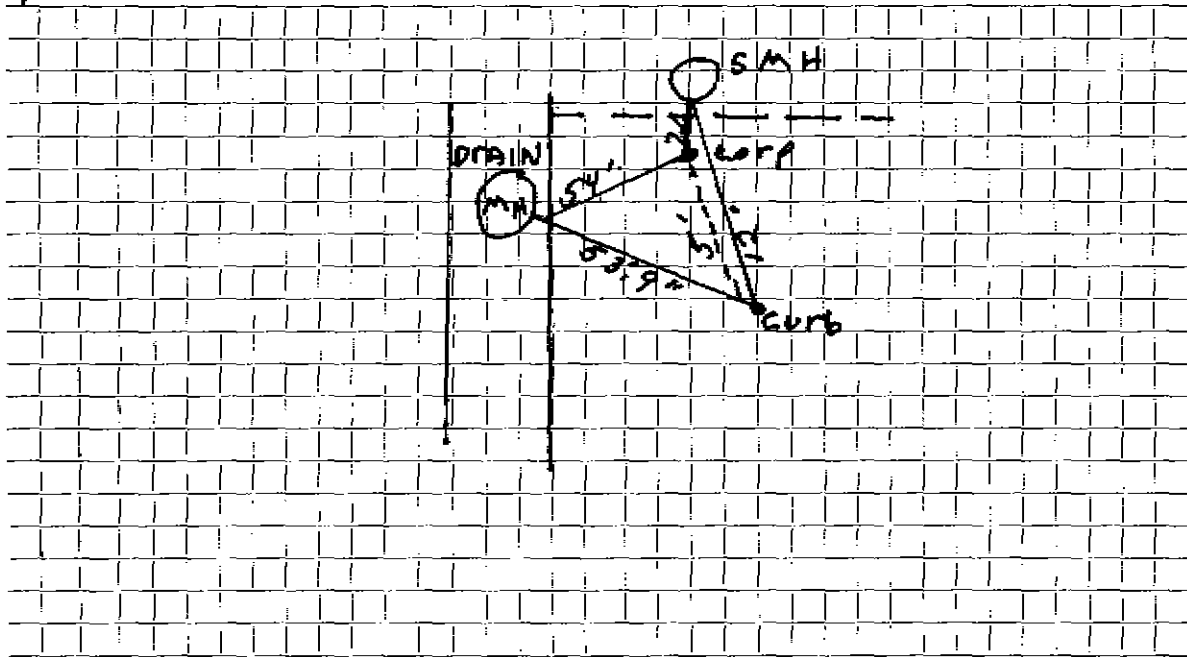

Connection made in Street. Work completed

Remarks:

.....

.....