

EAST STREET

Street

62/22

Lot No.

is hereby notified that
the proper number is

146

BOARD OF SELECTMEN

By

Peter Karalaxis

changed from # 150

6432 MARAN P.T.G.

Greenhouses + Stand will Remain # 150

Doran House will now be # 146

DATE May 22, 1935

TOWN OF LEXINGTON—BOARD OF PUBLIC WORKS

WATER DIVISION

The undersigned applies for a supply of water at No. East Street St. and hereby agrees to comply with the rules and regulations as now, or at any future time, established by the Board of Selectmen.

Am't. of Estimate \$ 15.00

Owner Eleanor A. Toran - B.D.D.


Am't. Paid \$ _____

Address 1686 Mass Ave

Builder _____

Temporary service
Lexington

Sketch of Service Here

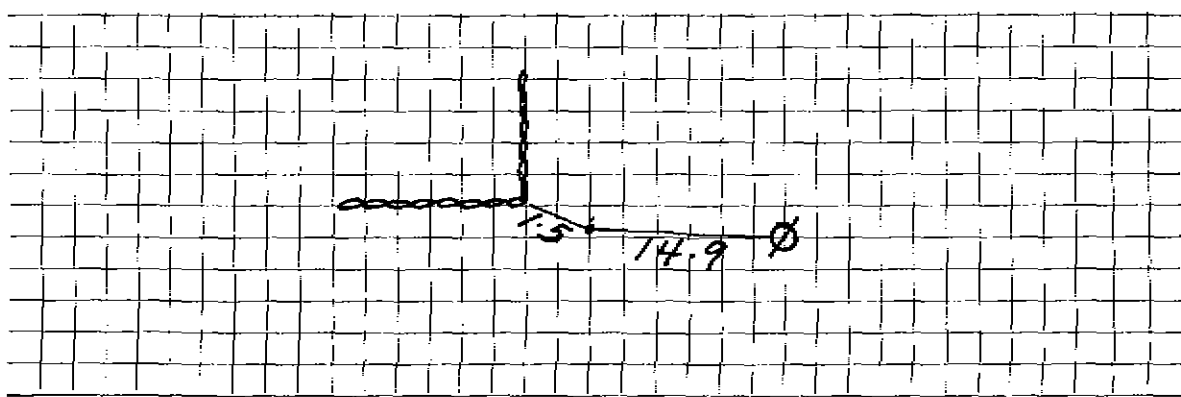

Connection made in _____ Street.

Work completed _____ 19

Remarks:

Please update the cards.

Thanks
Jeanne



TOWN OF LEXINGTON

OFFICE OF SELECTMEN

2-26-05

Date

To GUY & ELAINE DORAN

Under Article 6 section 2 of the General By-Laws of the Town of Lexington, it is ordered that "The Selectmen shall determine and designate numbers for the buildings abutting upon or adjacent to such streets or portions of streets as they may deem best for public convenience. No person shall neglect or refuse to affix to any building owned by him, the street number designated for him by said board."

The owner of the building on