

# WATER SERVICE RECORD

# 6130

Name **John Morrow**

Service No. **1**

Address **151 East Street**

Location

Repair ~~XXXXXXXXXXXXXXXXXX~~

W.O. #7794

Comm 4-22-60


Date	Material	Amount	Total	Date	Description	Amount
2-25-63	Labor	32.55		2-25-63	Deposit	50.00
	10% O.H.	3.26	35.81	4-23-63	Paid	8.18
15'	3/4" Copper tubing @.42		6.30			58.18
1	3/4" G 3 part union		2.41			
1	3/4" x 1" G 2 part union		1.62			
1	1" Style 38 Repair Clamp		2.26			
1	1" x 4" C.L. Nipple		.28			
1	hr. Town Shovel @6.50		6.50			
1	hr. Trucking @3.00		3.00			
			58.18			
					Bill 8.18	

DATE \_\_\_\_\_

TOWN OF LEXINGTON — BOARD OF PUBLIC WORKS

WATER DIVISION

Sketch of Service Here

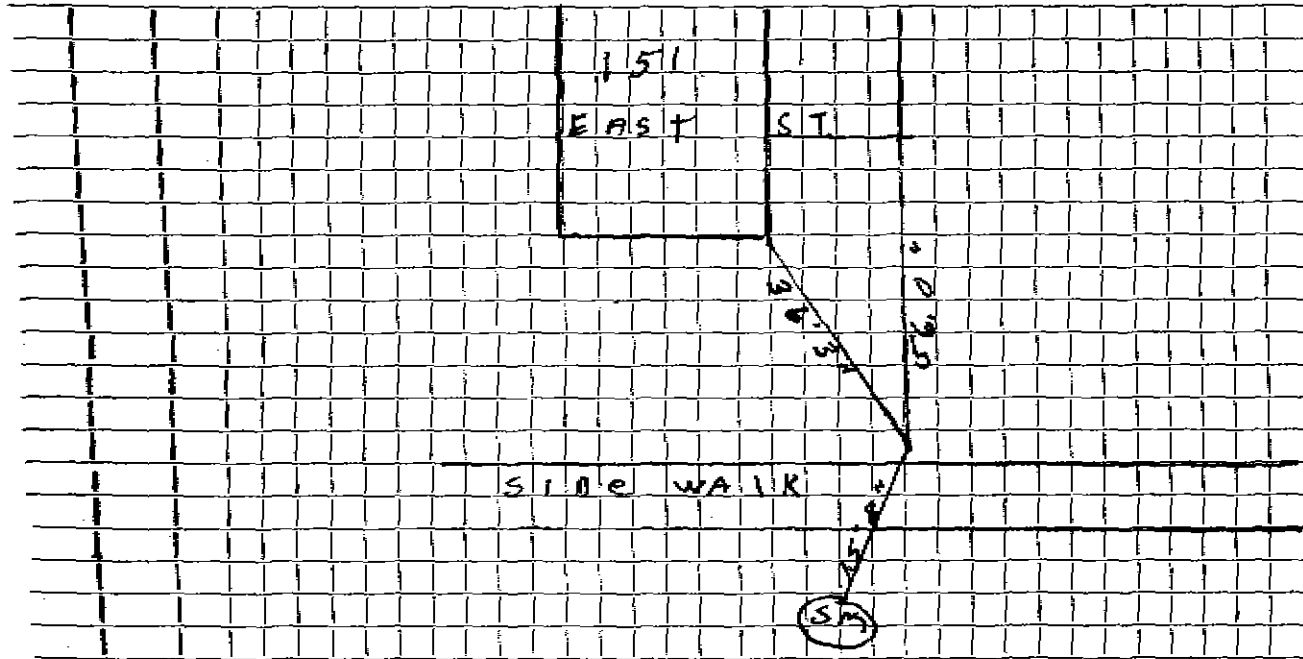

Connection made in \_\_\_\_\_ Street. Work completed \_\_\_\_\_

Remarks: \_\_\_\_\_  
\_\_\_\_\_  
\_\_\_\_\_