

WATER SERVICE RECORD

Name Ralph D. Cataldo

Service No. 125

Address 157 East Street

Location

~~Renewal~~ - New Service

Comm. 11-19-56


Date	Material	Amount	Total	Date	Amount
6/4/56	Labor	1 95		5-31-56	Deposit 100 00
	10% overhead	20	2 15	11-19-56	Refund 64 01
	58' - 3/4" Copper tubing @ .4850	28 13			<u>NON CHARGE</u> 35 99
	1 - 3/4" Cx 1/2 I.W.H. Stop & Waste	4 96		6/4/56	Labor 5 15
	1 hr. trucking		75		10' - 3/4" Copper tubing @ .4850 4 85
			35 99		1 - 3/4" C. Corp Cock 4 64
					1 - 3/4" C. Curb Cock 5 94
					1 Box & Rod 4 62
					1 - 1/2 Straight tailpiece 50
					1 - 1/2 Offset tailpiece 50
					<u>26 20</u>

DATE _____

TOWN OF LEXINGTON — BOARD OF PUBLIC WORKS

WATER DIVISION

Sketch of Service Here

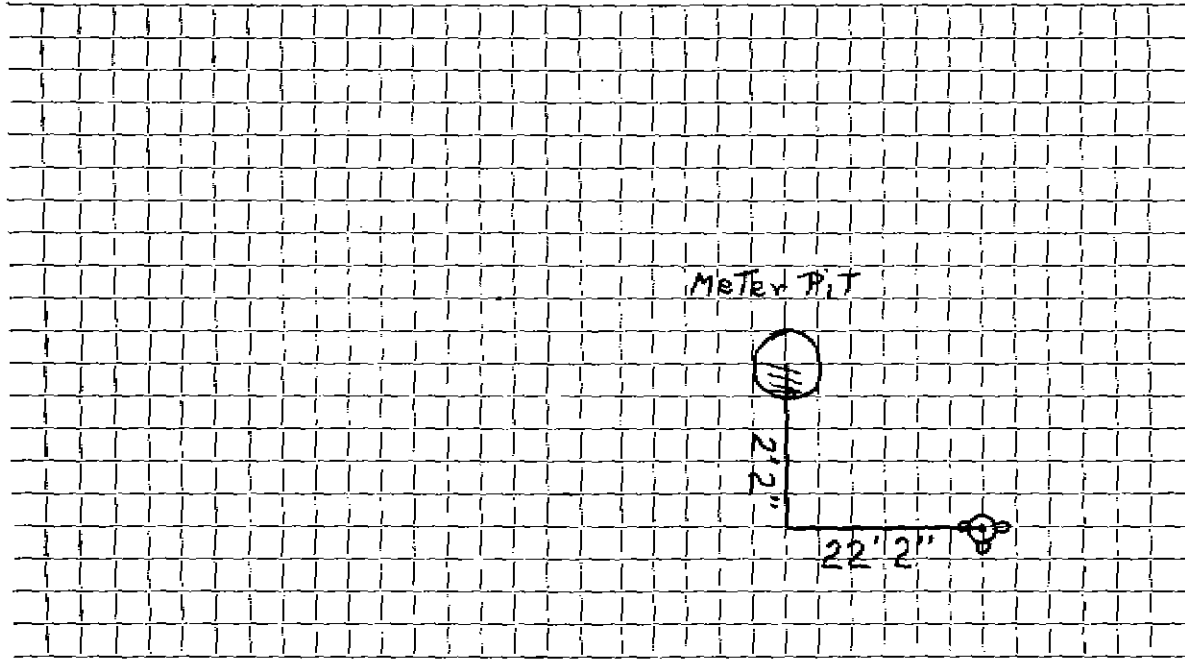

Connection made in Street. Work completed

Remarks: Original 9-11-39 ... old service killed at main 5-2-74

.....
.....