

WATER SERVICE RECORD

Name

Service No.

Address 168 East Street

Location

~~Repair~~ - Renewal - ~~New Service~~
XXXXX XXXXXXXXXXX

W.O.#2107.

'Outside'


Date	Material	Amount	Total	Date	INSIDE McLaughlin's Amount
5-17-74	Labor		\$112.24	3/79	19' 1" COPPER
	21 1" Copper Pipe @1.35		28.35		1 1" VALVE
	1 1" Corporation		15.17		1 Buffle Box
	1 1" Curb Cock		16.97		
	1 Box & Rod		12.95		
	1 2" 6 x 12 nipple		1.04		
	1 2" Repair Clamp				
	1 2" x 1" Coupling		5.10		
	2 Hrs. Trucking @3.00		6.00		
	2 Hrs. Town Shovel @6.50		13.00		
			<u>\$210.82</u>		

DATE _____

TOWN OF LEXINGTON — BOARD OF PUBLIC WORKS

WATER DIVISION

Sketch of Service Here

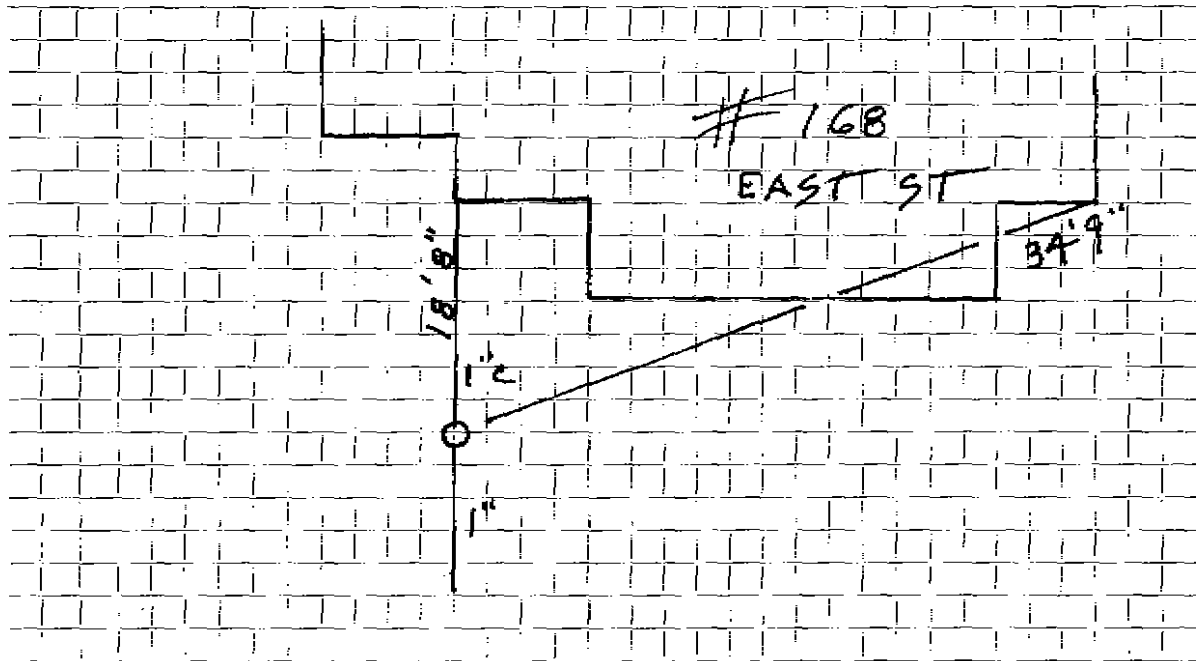

Connection made in Street. Work completed

Remarks:

.....
.....