

WATER SERVICE RECORD

#3273

Name George Bailey

Service No. 258

Address ¹⁷⁶⁻¹⁷⁷
172 East Street

Location

~~Repair—Renewal—New Service~~


Comm. 12/31/57

Date	Material	Amount	Total	Date	Amount
11/15/57	Labor	14 18		11-5-57	Deposit \$ 150 00
	10% overhead	1 42	15 60	12-31-57	Refund 72 74
	60' - 3/4" Copper tubing @ .37	22 20			NON CHARGE \$ 77 26
	1 - 3/4" Cx 1/2 I.W.H. Stop & Waste	4 96		11/16/57	Labor 28 36
	2 hrs. Trucking @ .75	1 50		24' - 3/4" Copper tubing @ .37	8 88
	2 hrs. Town Shovel @ 6.50	13 00		1 - 3/4" C. Corp Cock	4 64
	20x3 Patch	20 00		1 - 3/4" C. Curb Cock	5 94
			77 26	1 Box & Rod	4 62
				1 - 1/2 Straight tailpiece	50
				1 - 1/2 Offset tailpiece	50
				2 hrs. Town Shovel @ 6.50	13 00
				1 hr. Trucking	75
					67 19

DATE _____

TOWN OF LEXINGTON — BOARD OF PUBLIC WORKS
WATER DIVISION

Sketch of Service Here

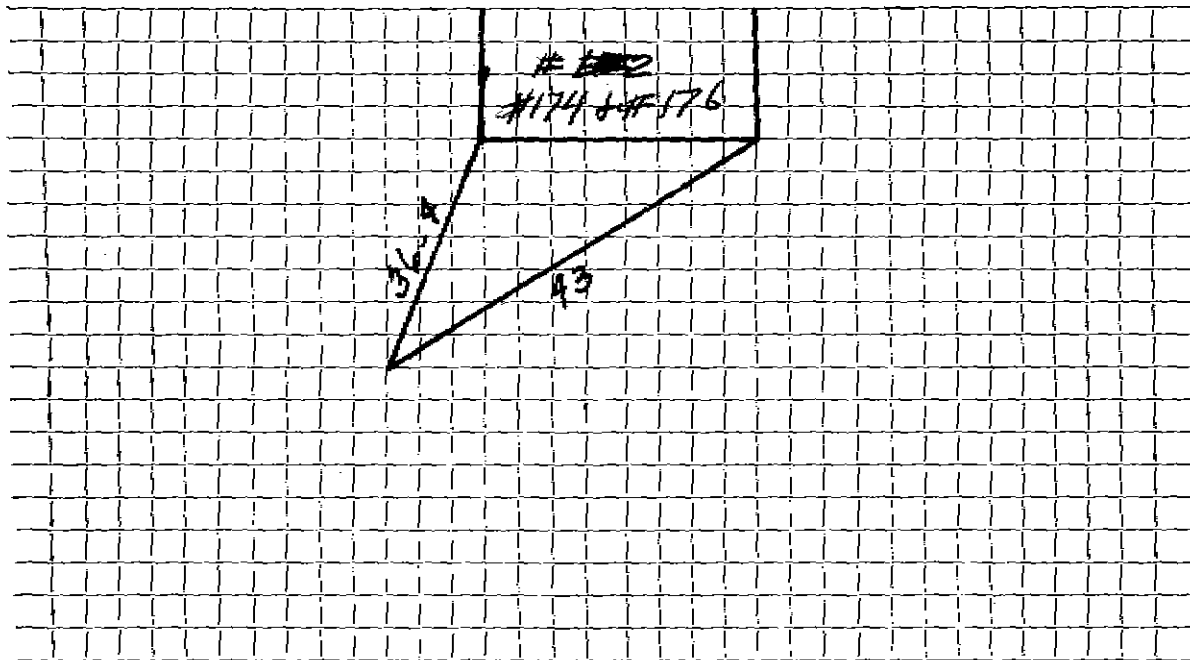

Connection made in Street. Work completed

Remarks:

.....

.....