

WATER SERVICE RECORD

Name C. J. Eliades

Service No. 40

Address 175 EAST ST.

Location

~~Repair or Renewal~~ — New Service DeFlice Bros. #3130 W.O.#1232

APR 8 1974


Date	Material	Amount	Total	Date	Amount
				9-4-73	100.00
10-10-73	20' 3/4" Copper			2-30-86	6.79
9/10/73	Labor	50.10			106.79
	10% O.H.	5.01	55.11		
	16' 3/4" Copper @ .60/ft.		9.60		
	1 3/4" Corporation		7.42		
	1 3/4" Curb cock		11.32		
	1 Box and rod		7.34		
	1 hr. Trucking @ 3.00		3.00		
	2 hrs. Town Shovel @ 6.50		13.00		
			\$106.79		

DATE _____

TOWN OF LEXINGTON — BOARD OF PUBLIC WORKS

WATER DIVISION

Sketch of Service Here

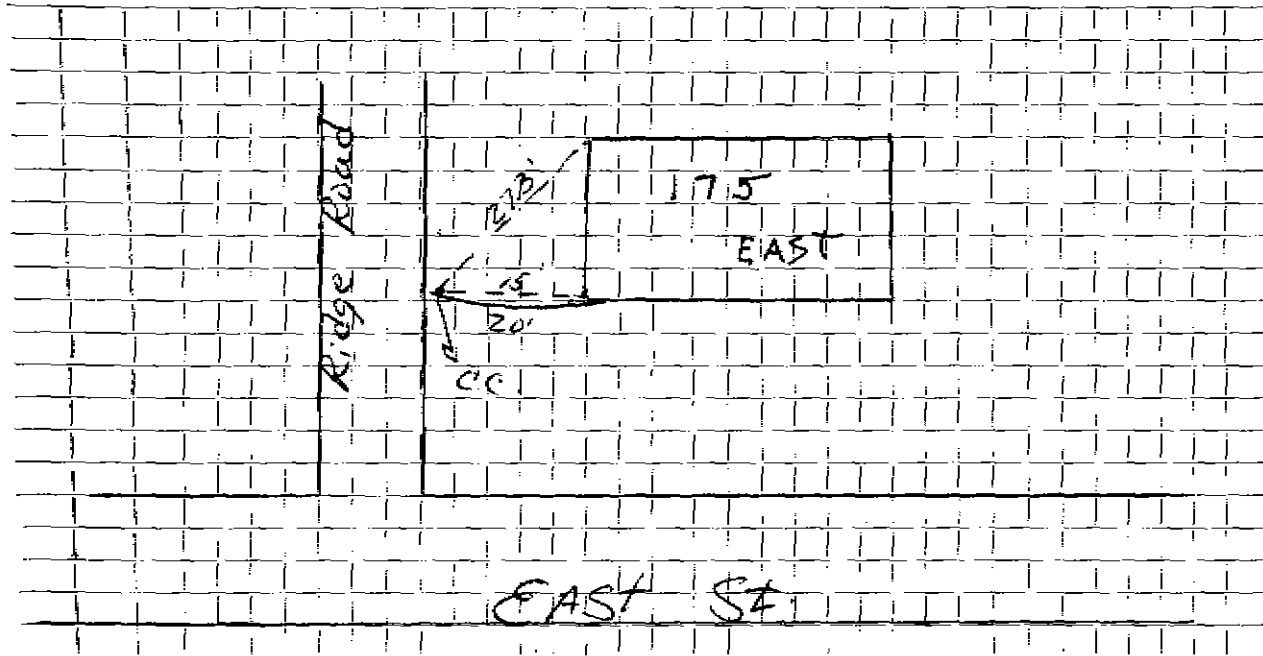

Connection made in Street. Work completed

Remarks:
.....
.....