

Name Lexington Const. Co.

1186

Service No.

Address 191 East Street

# 885

Lexington, Mass.

Location 191 East Street

Kind of Pipe

Size

Size of Main

~~Repair~~ ~~Renewal~~ - New Service

Com. 8023-48

Location

Date

Material

Amount

Total

Date

Amount

June 22, '48	Labor	4 00	4 00
	10% Overhead		40
	37' - 3/4" Copper Tubing @ .255	9 44	9 44
	1 - 3/4" C x 3/8" P.W.E. S & W	3 15	3 15
	1 - 3/4" C x 3/4" C Union 3pts.	1 32	1 32
	Littlefield Shovel 1 hr. @ 7.00	7 00	7 00
	Trucking 1 hr. @ .75		75
	Patching 19 x 3		19 00
			45 06

Labor

May 12 48  
 June 4 48  
 Oct 1 48

Deposited  
 Paid

35 00  
 10 06  
 45 06

Non-Charge

June 22, '48	Labor	4 40
55' - 3/4" Copper Tubing @ .255		14 03
1 - 3/4" C Corp-cock		3 00
1 - 3/4" C x 3/4" C Gurb-cock		3 68
1 - 3/4" C x 3/4" C Union (3pts)		1 32
1 - 3/4" Offset Tail Piece		30
1 - 3/4" Straight Tail Piece		30
1 - Box & Rod		3 50
Littlefield Shovel 2 hr. @ 7.00		14 00
Trucking 1 hr. @ .75		75
		45 28

DATE \_\_\_\_\_

# TOWN OF LEXINGTON—BOARD OF PUBLIC WORKS

## WATER DIVISION

The undersigned applies for a supply of water at No. \_\_\_\_\_ St. and hereby agrees to comply with the rules and regulations as now, or at any future time, established by the Board of Selectmen.

Am't. of Estimate \$ \_\_\_\_\_


Owner \_\_\_\_\_

Am't. Paid \$ \_\_\_\_\_

Address \_\_\_\_\_

Builder \_\_\_\_\_

Sketch of Service Here

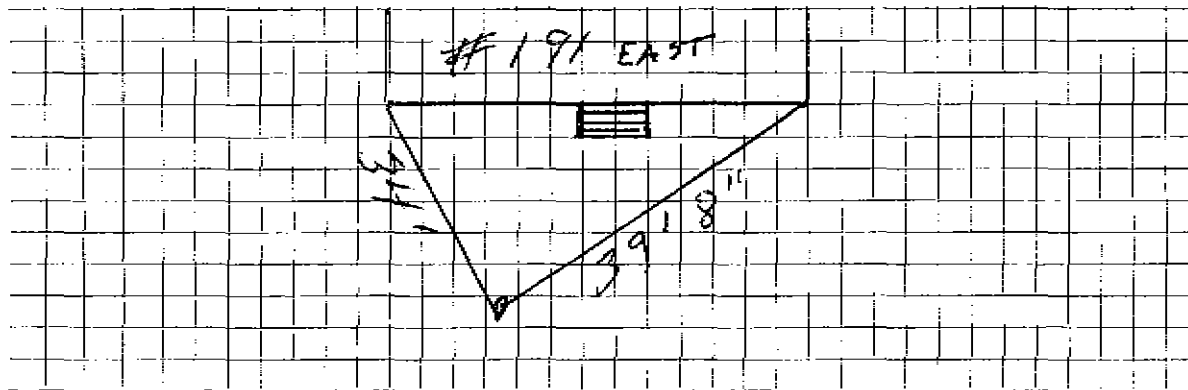

Connection made in \_\_\_\_\_

Street.

Work completed \_\_\_\_\_

19

Remarks: