

Name Lexington Construction Co.

Service No.

#5551

Address 197 East Street

Lexington, Mass.

Location 197 East Street

Kind of Pipe

Size

Size of Main

Repair - Renewal - New Service

Com. 8-23-48

Location

Date	Material	Amount	Total	Date	Amount
June 21, '48	Labor	1.00	1.00	May 12, '48	
	10% Overhead		.10	June 4, '48	
	37' - 3/4" Copper Tubing @ .255	9.14	9.14	Oct 1, '48	
	1 - 3/4" C x 3/8" I.S.F. S & W	3.15	3.15		
	Littlefield Shovel 2 hr. @ 7.00	7.00	7.00	June 21, '48	Labor
	Trucking 1 hr. @ .75	.75	.75		6.30
	Patching 19 x 3		19.00		10.71
			43.74		3.00
					3.68
					1.32
					30
					30
					14.00
					.75
					43.86
	Labor				

May 12 '48
June 4 '48
Oct 1 '48
Deputed
to do
 Non-Charge

35.00
8.74
 43.74

Hadley Press, Inc., Lexington

DATE _____

TOWN OF LEXINGTON—BOARD OF PUBLIC WORKS

WATER DIVISION

The undersigned applies for a supply of water at No. _____ St. and hereby agrees to comply with the rules and regulations as now, or at any future time, established by the Board of Selectmen.

Am't. of Estimate \$ _____


Owner _____

Am't. Paid \$ _____

Address _____

Builder _____

Sketch of Service Here

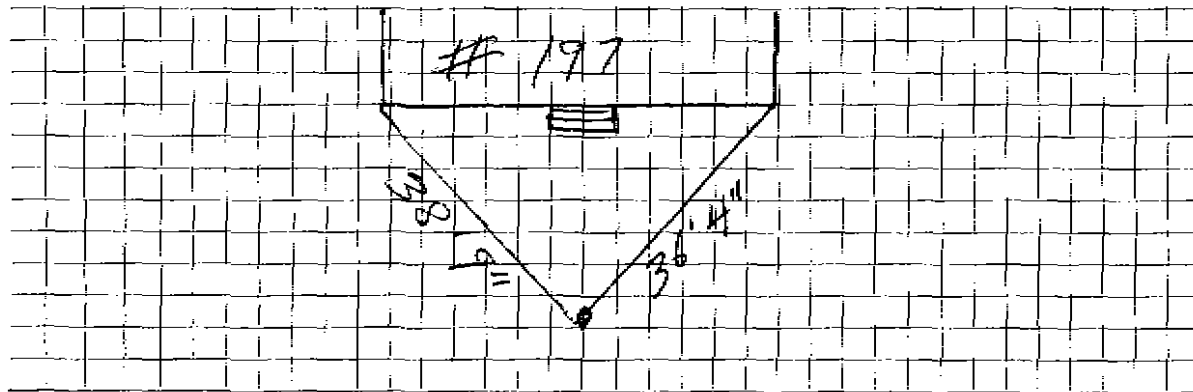

Connection made in _____

Street.

Work completed _____

19

Remarks: