

Name Mrs. Margaret Crowley

Service No. ~~88~~ 772

Address 198 East St. 196 West St., Lexington Feb Renewed 5-74 #3751

Location Checked 3/4" Copper 5-9-74 #3752

Kind of Pipe

Size Tony

Size of Main

~~Repair~~ Renewal - New Service

Location

Date	Material	Amount	Total	Date	Amount
27	1" C.L. Pipe @ .27	\$7 29			
1	1" L.L. Coup.	25		Dec. 28 1931 - Cash	15 -
1	1" L.L. Ell	30		12, 1935 - Check	5 25
1	1" Br. Sp. Kip.	20			21 25
1	S & W	3 00			
	Trucking	75	12 54		
12/24/31	7 Hrs. Labor @ .65	3 85			
3	" " @ .60	1 80	5 65		
	15% Overhead		85		
			19 04		
	<b>Labor</b>				
CHARGE	27 ft. @ .75	\$20 25	\$20 25		

Hadley Press, Inc. Lexington

COST

CHARGE

DATE \_\_\_\_\_

# TOWN OF LEXINGTON - BOARD OF PUBLIC WORKS WATER DIVISION

The undersigned applies for a supply of water at No. \_\_\_\_\_ St. and hereby agrees to comply with the rules and regulations as now, or at any future time, established by the Board of Selectmen.

Am't. of Estimate \$ 5.00

Owner Mrs. Margaret E. Crowley


Am't. Paid \$ \_\_\_\_\_

Address 197 East St

Builder \_\_\_\_\_

Lexington  
Mass

Sketch of Service Here

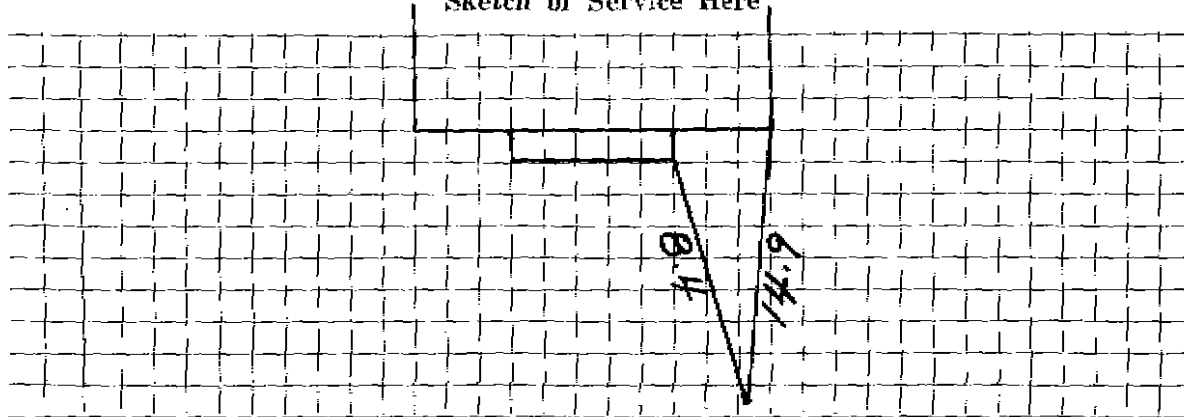

Connection made in \_\_\_\_\_ Street. Work completed \_\_\_\_\_ 19

Remarks: