

Name Lexington Construction Co.

Service No.

Address 201 East Street

Lexington, Mass.

Location 201 East Street

Kind of Pipe

Size

Size of Main

Repair—Renewal—New Service

Com. 8-23-48

Location

Date	Material	Amount	Total	Date	Amount	
Jul. 9, '48	Labor	3 20	3 20	May 13 48	<i>Deposited and non-charge</i>	35 00
	20% Overhead		32	June 4 48		5 18
	37' - 3/4" Copper tubing @ .255	9 44		Oct 1 48		40 18
	1 - 3/4" C x 3/8" L.S.T. S & S	3 15				
	1 - 3/4" C x 3/4" Union (3pts)	1 32		June 22, '48	Labor	7 35
	Littlefield Shovel 1 hr.	7 00	7 00	42' - 3/4" Copper tubing @ .255		10 72
	Trucking 1 hr. @ .75		75	1 - 3/4" C Wye-cock		3 00
	Patching 15 x 3		15 00	1 - 3/4" C x 3/4" Wye-cock		3 60
			40 18	1 - Box & Rod		3 15
				1 - 3/4" Straight Tail Piece		30
				1 - 3/4" Offset Tail Piece		30
				Littlefield Shovel 2 hrs. @ 7.00		14 00
				Trucking 1 hr. @ .75		75
	Labor					<u>43 64</u>

DATE _____

TOWN OF LEXINGTON—BOARD OF PUBLIC WORKS

WATER DIVISION

The undersigned applies for a supply of water at No. _____ St. and hereby agrees to comply with the rules and regulations as now, or at any future time, established by the Board of Selectmen.

Am't. of Estimate \$ _____


Owner _____

Am't. Paid \$ _____

Address _____

Builder _____

Sketch of Service Here

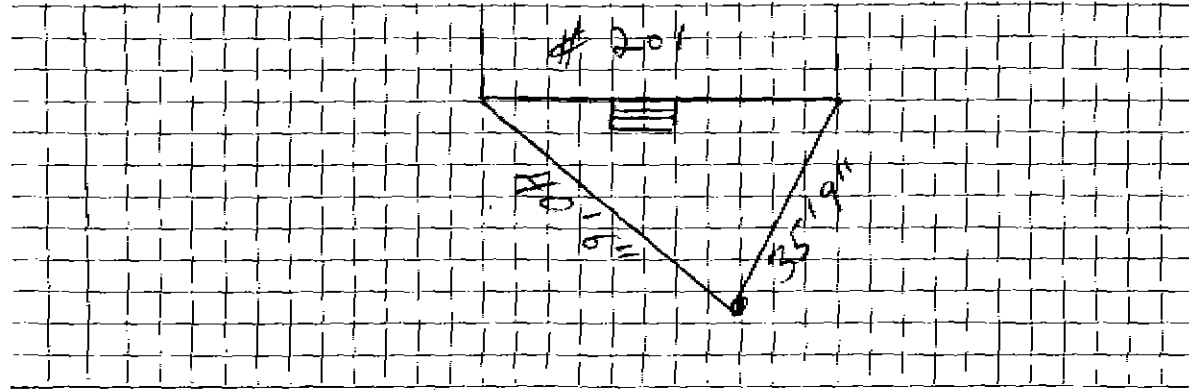

Connection made in _____ Street.

Work completed _____ 19

Remarks: