

Name Lexington Construction Co.

Service No. 170 635

Address 202 East Street
Lexington, Mass.

Location 202 East Street

Kind of Pipe

Size

Size of Main

~~Repair~~ ~~Renewal~~ New Service

Com. 11-8-49

Location

Date

Material

Amount

Total

Date

Amount

Oct. 11, '49

Labor

1 30

1 30

Sept 20 '49

Deposited

25 00

10% Overhead

13

Nov 10 '49

Withdrawal

25 00

33' - 3/4" Copper Tubing @ .24

7 92

N^o Charge

13 39

1 - 3/4" C x 1/2" I.W.H S&W

3 29

1 - 1/2" Offset Tail Piece

37

Trucking 1 hr. @ .75

75

1 - 1/2" Straight Tail Piece

37

13 39

74

Service formerly garden pit

5-2-74

Copper into house

Labor

DATE _____

TOWN OF LEXINGTON - BOARD OF PUBLIC WORKS

WATER DIVISION

The undersigned applies for a supply of water at No..... St. and hereby agrees to comply with the rules and regulations as now, or at any future time, established by the Board of Selectmen.

Am't of Estimate \$.....


Owner

Am't Paid \$.....

Address

Builder

Sketch of Service Here

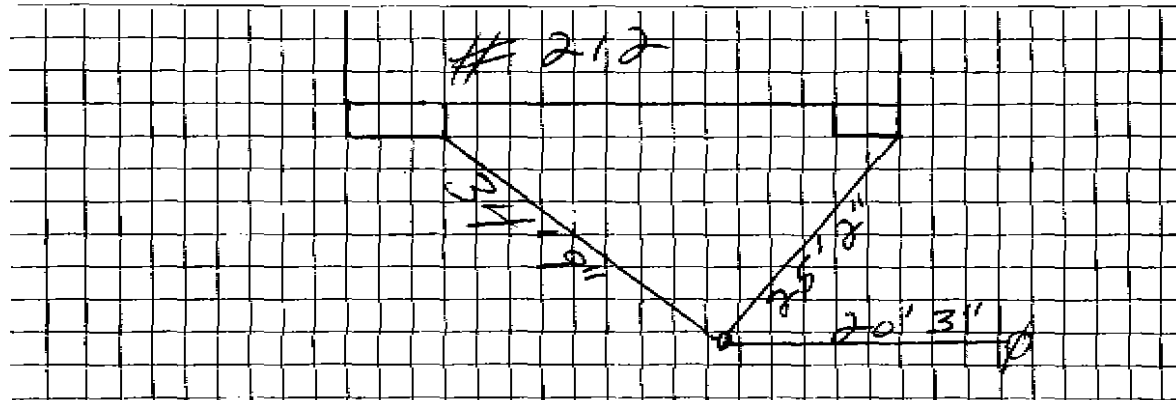

Connection made in Street.

Work completed19

Remarks: