


DATE 7/20/17

TOWN OF LEXINGTON — BOARD OF PUBLIC WORKS

WATER DIVISION

Sketch of Service Here

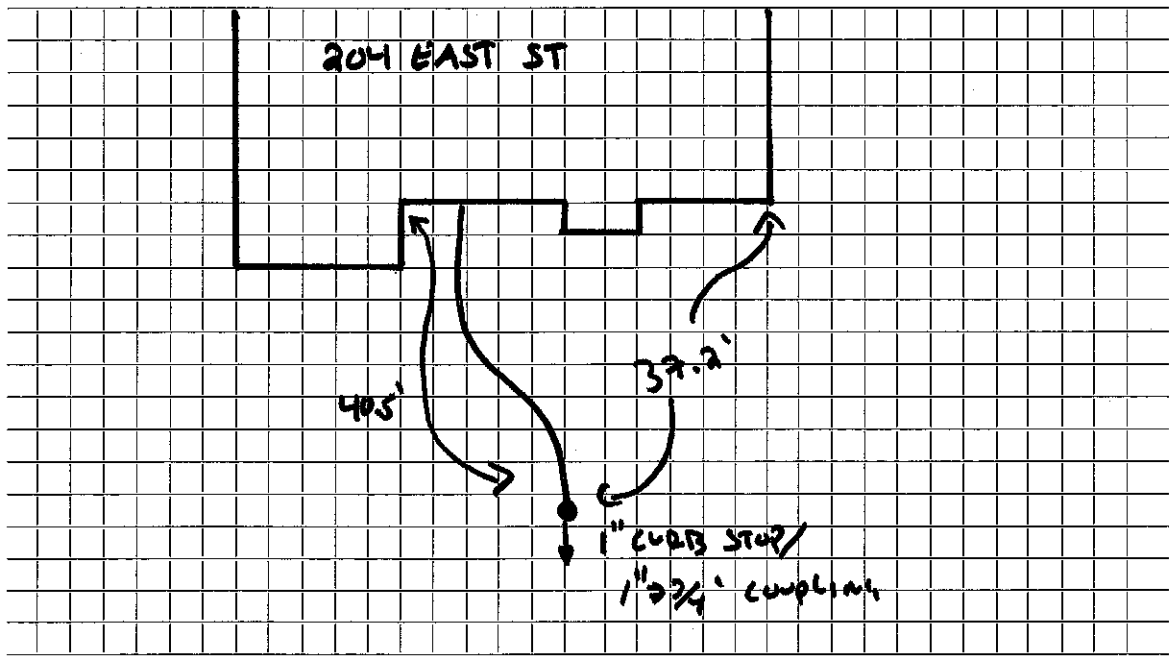

Connection made in EAST Street. Work completed MCLAUGHLIN

Remarks:

.....

.....