

Name Lexington Construction Co.

Service No.

97

Address 208 East Street

694

Location 208 East Street

Kind of Pipe

Size

Size of Main

~~Repair - Renewal~~ - New Service

Com. 8-15-49

Location

Date

Material

Amount

Total

Date

Amount

Date	Material	Amount	Total
June 14, '49	Labor	1 25	1 25
	10% Overhead		13
	27' - 3/4" Copper Tubing @.24	6 48	
	1 - 3/4" C x 1/2" I.W.H. S&W	3 29	
	Trucking 1 hr. @.75	75	
	Patching 3 x 3		3 00
			14 90
	Labor		

Date	Material	Amount
June 7, '49	Deposited	15 00
	Non-Charge	
June 14, '49	Labor	9 08
	10' - 3/4" Copper Tubing @.24	2 40
	1 - 3/4" C Corp-cock	3 15
	1 - 3/4" C x 3/4" C Curb-cock	3 85
	1 - Box & Rod	3 95
	1 - " Offset Tail Piece	37
	1 - 1/2" Straight Tail Piece	37
	Littlefield Shovel 1 1/2 hrs. @7.00	10 50
	Trucking 1 hr. @.75	75
		34 42

DATE _____

TOWN OF LEXINGTON - BOARD OF PUBLIC WORKS

WATER DIVISION

The undersigned applies for a supply of water at No..... St. and hereby agrees to comply with the rules and regulations as now, or at any future time, established by the Board of Selectmen.

Am't of Estimate \$.....

Owner


Am't Paid \$.....

Address

Builder

.....

Sketch of Service Here

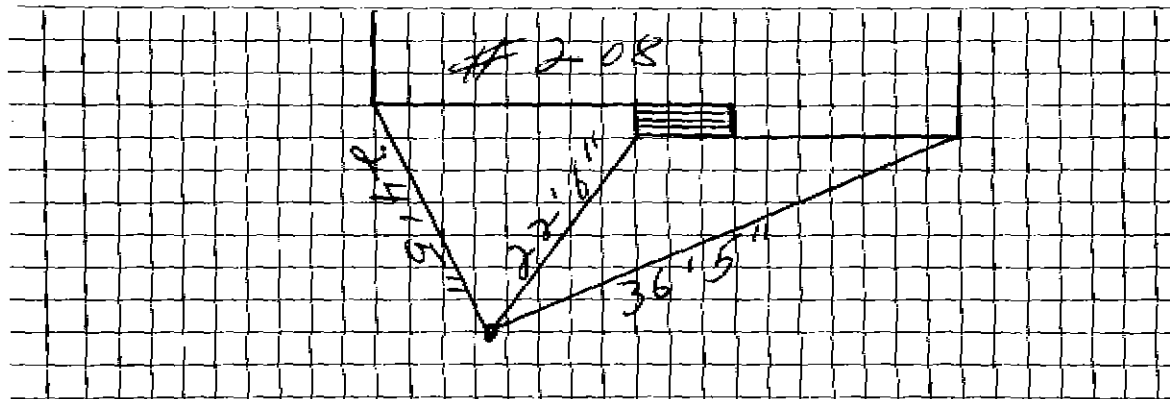

Connection made in Street.

Work completed19

Remarks: