

Name Lexington Construction Co.

Service No.

Address 213 East Street

#1653

Lexington, Mass.

Location 213 East Street

Kind of Pipe

Size

Size of Main

~~Repair-Renewal~~ New Service

Com. 8-23-48

Location

Date

Material

Amount

Total

Date

Amount

Date	Material	Amount	Total	Date	Amount
Jul. 9, '48	LS Labor	3 20	3 20	May 12, '48	
	10% Overhead		32	June 4, '48	
	37' - 3/4" Copper Tubing @.255	9 44		Oct 1, '48	
	1 - 3/4" C x 1/2" I.W.R. S & W	3 15			Deposited
	1 - 3/4" C x 3/4" C Union (3pts)	1 32			Car
	Littlefield Shovel 1 hr. @ 7.00	7 00			Non-Charge
	Trucking 1 hr. @ .75		75	Jul. 9, '48	Labor
	Patching 15 x 3		15 00		42' - 3/4" Copper tubing @.255
			40 18		1 - 3/4" C Corp-cock
					1 - 3/4" C x 3/4" C carb-cock
					1 - Box & Rod
					1 - 1/2" Offset Tail Piece
					1 - 1/2" Straight Tail Piece
					Littlefield Shovel 2 hrs. @ 7.00
					Trucking 1 hr. @ .75
	Labor				

Hadley Press, Inc., Lexington

DATE \_\_\_\_\_

# TOWN OF LEXINGTON—BOARD OF PUBLIC WORKS

## WATER DIVISION

The undersigned applies for a supply of water at No. \_\_\_\_\_ St. and hereby agrees to comply with the rules and regulations as now, or at any future time, established by the Board of Selectmen.

Am't. of Estimate \$ \_\_\_\_\_


Owner \_\_\_\_\_

Am't. Paid \$ \_\_\_\_\_

Address \_\_\_\_\_

Builder \_\_\_\_\_

Sketch of Service Here

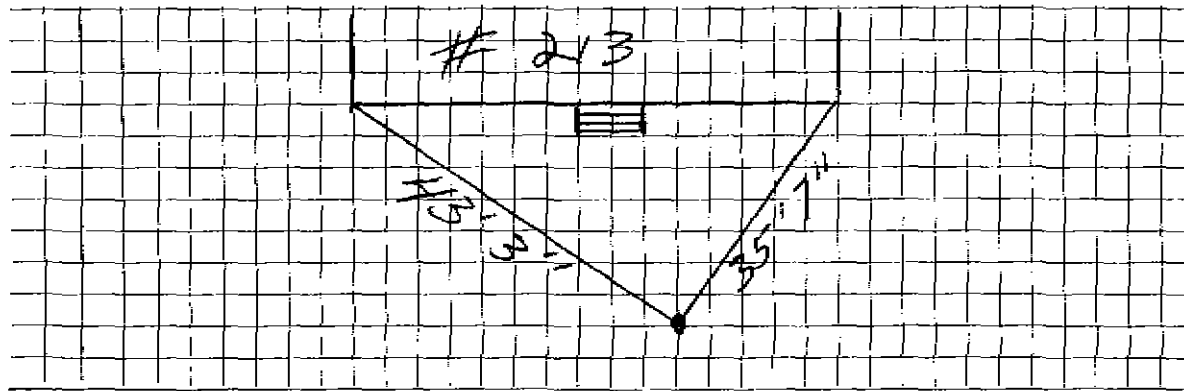

Connection made in \_\_\_\_\_ Street. Work completed \_\_\_\_\_ 19\_\_

Remarks: