




DATE 7/2017

TOWN OF LEXINGTON — BOARD OF PUBLIC WORKS

WATER DIVISION

Sketch of Service Here

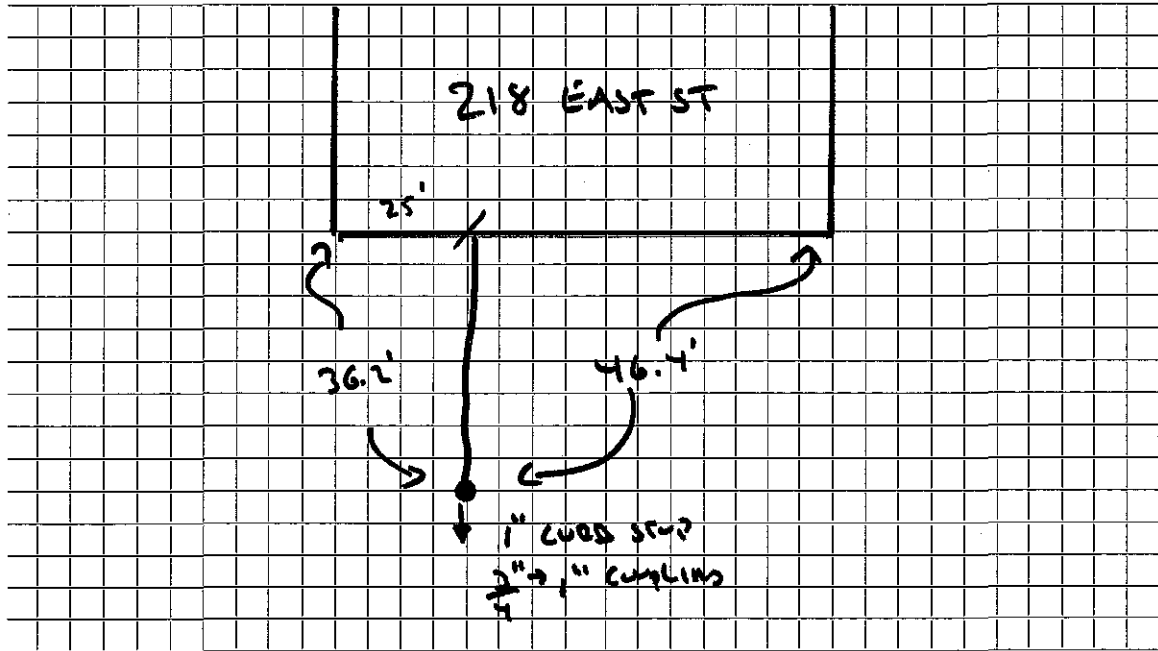

Connection made in W. ASK Street. Work completed KIELY EXCAVATION

Remarks: EXISTING 3/4\"