

Name Lexington Construction Co.

Service No.

259  
# 4552  
# 4553

Address 223 East Street

Lexington, Mass.

Location 223 East Street

Kind of Pipe

Size

Size of Main

~~Repair~~ ~~Renewal~~ - New Service

Location

Date	Material	Amount	Total	Date	Location	Amount
Nov. 5, '48	Labor	2 50	2 50	Oct 29 '48	Deposited	50 00
	10% Overhead		25	Dec 31 '48	Refunded	23 91
	37' - 3/4" Copper Tubing @ .255	9 44	9 44		Non-Charge	26 09
	1 - 3/4" C x 1/2" I.W.H. S&W	3 15	3 15	Nov. 4, '48	Labor	16 50
	Trucking 1 hr. @ .75	75	75	5	"	20 55
	Patching 10 x 3	10 00	10 00	86' - 3/4" Copper Tubing @ .255		9 18
			26 09	1 - 3/4" C Corp-cock		3 00
				1 - 3/4" C x 3/4" C Curb-cock		3 68
				1 - Box & Rod		3 55
				Compressor 1 hr. @ 1.75		1 75
	trench dug by owner.			1 - 1/2" Offset Tail Piece		30
				1 - 1/2" Straight Tail Piece		30
	Labor			Trucking 1 hr. @ .75		75
						59 56

TOWN OF LEXINGTON - BOARD OF PUBLIC WORKS

**WATER DIVISION**

The undersigned applies for a supply of water at No..... St. and hereby agrees to comply with the rules and regulations as now, or at any future time, established by the Board of Selectmen.

Am't of Estimate \$.....

Owner .....


Am't Paid \$.....

Address .....

Builder .....

.....

Sketch of Service Here

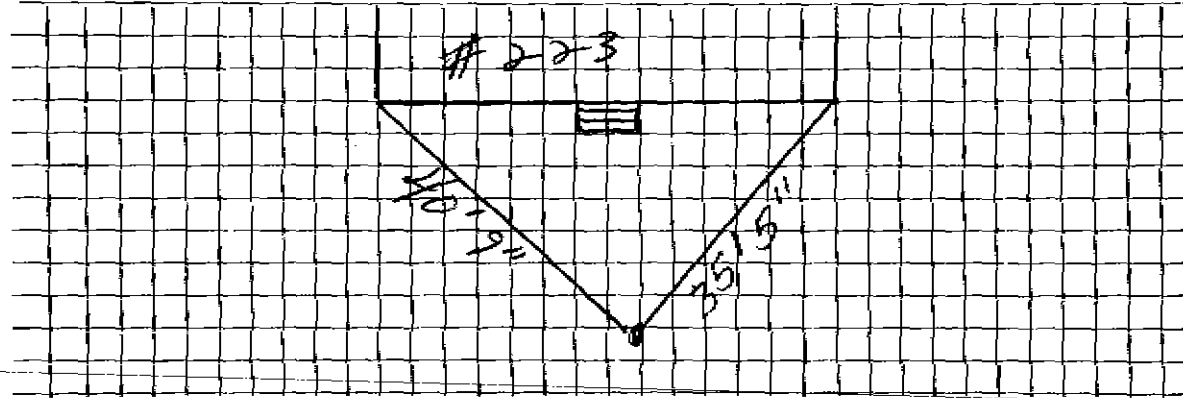

Connection made in ..... Street.

Work completed .....19

Remarks: