
TOWN OF LEXINGTON - BOARD OF PUBLIC WORKS

WATER DIVISION

The undersigned applies for a supply of water at No				
Am't of Estimate \$	Owner			
Am't Paid \$	Address			
Builder				
Sketch of Service Here				

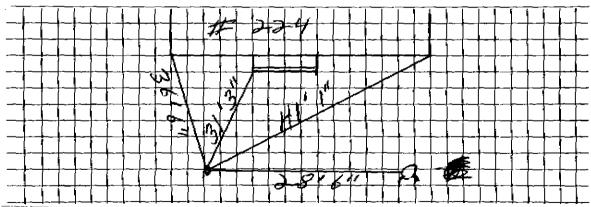

Connection	made in	***************************************	Street.	Work completed1

Remarks: