


DATE 5/31/18

TOWN OF LEXINGTON — BOARD OF PUBLIC WORKS

WATER DIVISION

Sketch of Service Here

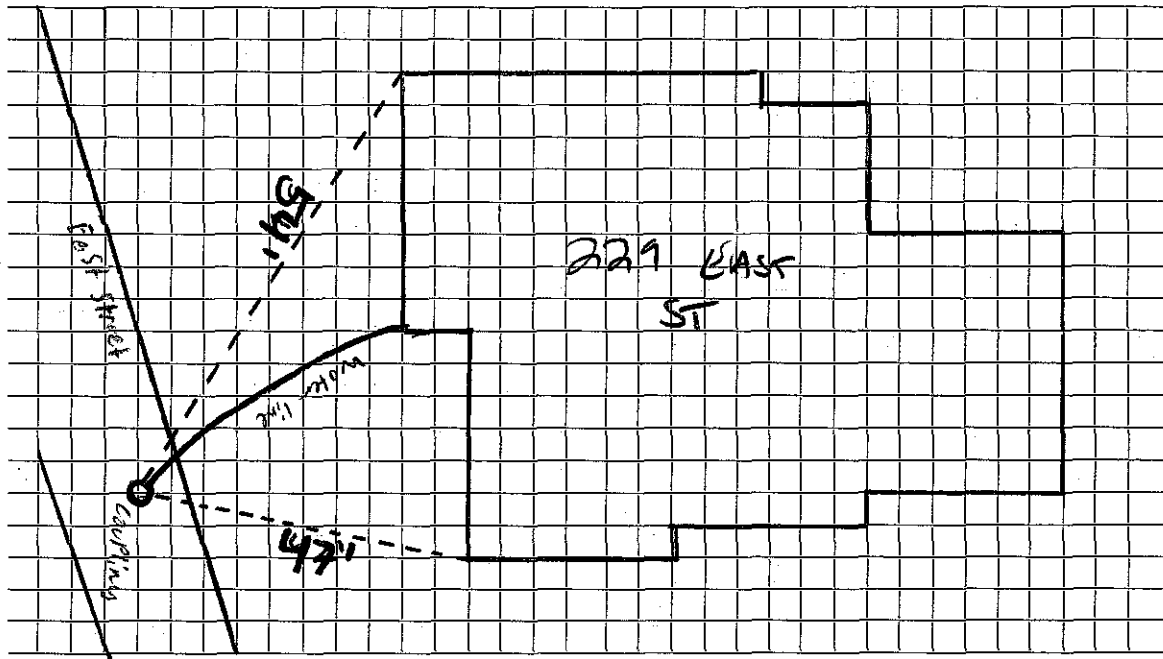

Connection made in East Street. Work completed

Remarks: Depth is 5.5'