

Name Lexington Construction Co.

2182 Service No.

259

Address 233 East Street

Lexington, Mass.

Location 233 East Street

Kind of Pipe

Size

Size of Main

Repair to Existing New Service

Location

Date	Material	Amount	Total	Date	Location	Amount
Nov. 6, '48	Labor	2 50	2 50	Oct 27, '48	Expended	50 00
	10% Overhead		25	Dec. 21, '48	Refunded	11 91
	37' - 3/4" Copper Tubing @.255	9 44	9 44		Non-Charge	38 09
	1 - 3/4" C x 1/2" I.W.H. S&W	3 15	3 15	Nov. 5, '48	Labor	15 60
	Trucking 1 hr. @.75	75	75	6	"	7 77
	Patching 22 x 3	22 00	22 00	33' - 3/4" Copper Tubing @.255		8 42
			38 09	1 - 3/4" C Corp-cock		3 00
	trench dug by owner.			1 - 3/4" C x 3/4" C Curb-cock		3 68
				1" Box & Rod		3 55
				Compressor 1 hr. @1.75		1 75
				1 - 1/2" Offset Tail Piece		30
				1 - 1/2" Straight Tail Piece		30
	Labor			Trucking 1 hr. @.75		75
						45 12

DATE _____

TOWN OF LEXINGTON - BOARD OF PUBLIC WORKS

WATER DIVISION

The undersigned applies for a supply of water at No..... St. and hereby agrees to comply with the rules and regulations as now, or at any future time, established by the Board of Selectmen.

Am't of Estimate \$.....

Owner


Am't Paid \$.....

Address

Builder

.....

Sketch of Service Here

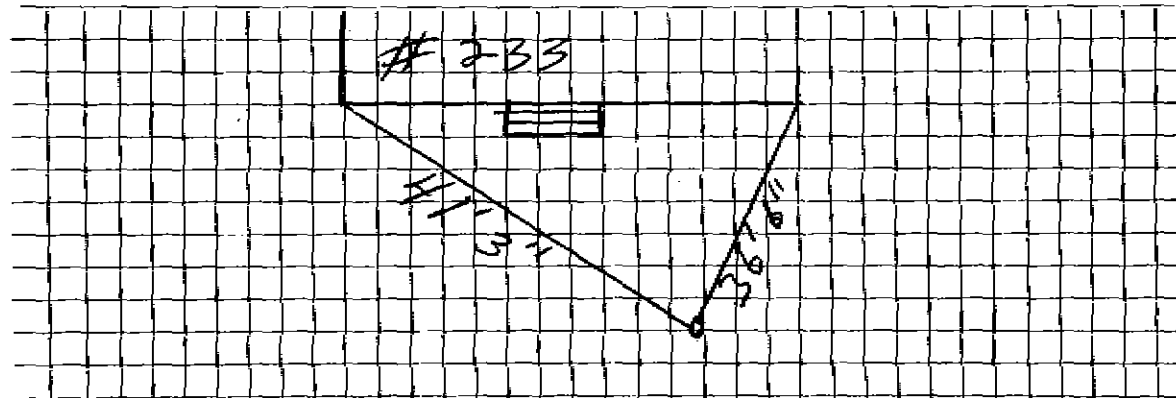

Connection made in Street.

Work completed19

Remarks: