

Name Lexington Const. Co.

Service No. 112

Address 234 East Street

#7566

Lexington, Mass.

Location 234 East Street

#2289

Kind of Pipe

Size

Size of Main

~~Repair~~ ~~Renewal~~ - New Service

Com. 11-8-49

Location

Date	Material	Amount	Total	Date	Material	Amount
Oct. 11, '49	Labor	1 30	1 30	Sept. 20, '49	Labor	20 00
	10% Overhead		13	Dec. 2, '49	Labor	1 00
	55' - 3/4" Copper Tubing @ .24	13 20	13 20		No Charge	26 06
	1 - 3/4" C x 1/2" I.W.H. S&W	3 29	3 29	Sept. 24, '49	Labor	5 95
	1 - 3/4" C x 3/4" C Union (3 pts)	1 39	1 39	8' - 3/4" Copper Tubing @ .24		1 92
	Trucking 1 hr. @ .75		75	1 - 3/4" C Corp-cock		3 15
	Patching 6 x 3		6 00	1 - 3/4" C x 3/4" C Curb-cock		3 85
			26 06	1 - Box & Rod		3 75
				1 - 1/2" Offset Tail Piece		37
				1 - 1/2" Straight Tail Piece		37
				Littlefield Shovel 1 hr. @ 7.00		7 00
				Trucking 1 hr. @ .75		75
	Labor					27 11

DATE \_\_\_\_\_

TOWN OF LEXINGTON - BOARD OF PUBLIC WORKS

**WATER DIVISION**

The undersigned applies for a supply of water at No. .... St. and hereby agrees to comply with the rules and regulations as now, or at any future time, established by the Board of Selectmen.

Am't of Estimate \$.....

Owner .....


Am't Paid \$.....

Address .....

Builder .....

.....

Sketch of Service Here

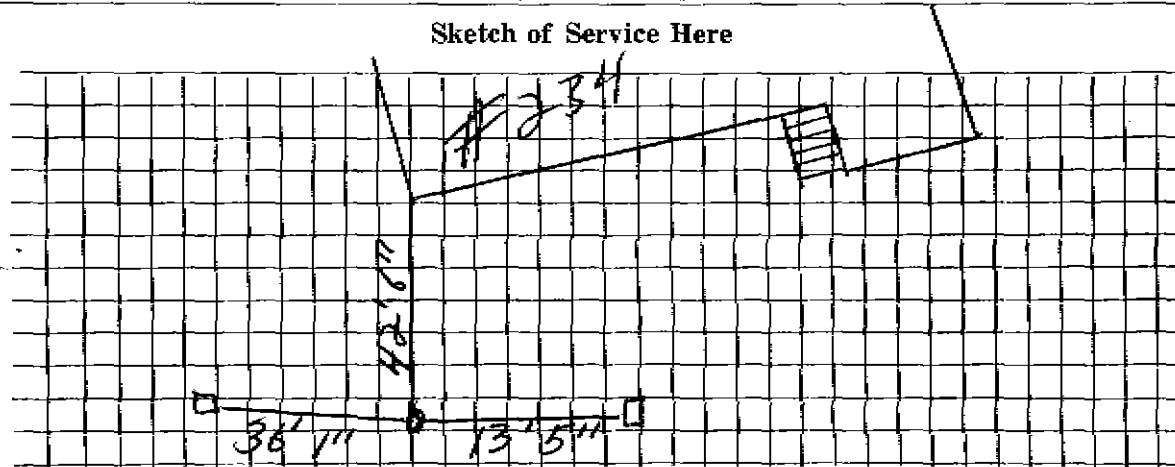

Connection made in ..... Street.

Work completed .....19

Remarks: