

Name Northeastern Realty Trust

Address 241 East Street

Lexington, Mass.

Location 241 East Street

Kind of Pipe

Size

Size of Main

~~Repair & Renewal~~ - New Service

Com. 9-5-50

Location

Date	Material	Amount	Total	Date	Amount	
Jul. 15, '50	Labor	3 45		<i>July 11, '50</i>	<i>Deposited</i>	50 00
Jul. 17, '50	Labor	<u>1 30</u>	4 75			
	10% Overhead		48		No Charge	<u>43 00</u>
	58' - 3/4" Copper Tubing @.23		13 34	Jul. 17, '50	Labor	4 32
	1 - 3/4"C x 1/2" I.W.H. S&W		3 29	22' - 3/4" Copper Tubing @.23		5 06
	1 - 3/4"C x 3/4"C Union (3pts)		1 39	1 - 3/4"C Corp-cock		3 15
	Littlefield Shovel 1 hr. @ 7.00		7 00	1 - 3/4"C x 3/4"C Curb-cock		3 85
	Trucking 1 hr. @.75		75	1 - Box & Rod		3 35
	Patching 12 x 3		<u>12 00</u>	1 - 1/2" Offset Tail Piece		38
			43 00	1 - 1/2" Tail Piece Straight		38
				Littlefield Shovel 1 1/2 hr s @ 7.00		10 50
				Trucking 1 hr. @.75		<u>75</u>
	Labor					<u>31 74</u>

Hadley Press, Inc., Lexington

DATE _____

TOWN OF LEXINGTON—BOARD OF PUBLIC WORKS

WATER DIVISION

The undersigned applies for a supply of water at No. _____ St. and hereby agrees to comply with the rules and regulations as now, or at any future time, established by the Board of Selectmen.

Am't. of Estimate \$ _____


Owner _____

Am't. Paid \$ _____

Address _____

Builder _____

Sketch of Service Here

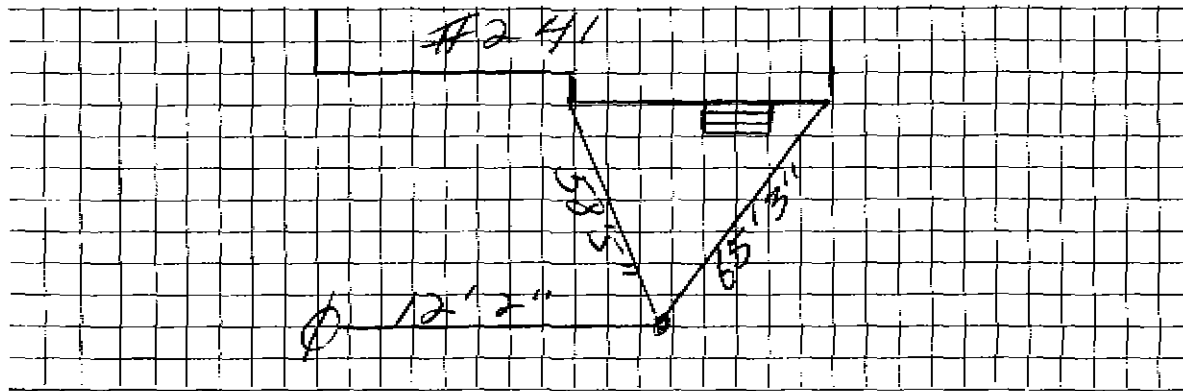

Connection made in _____ Street. Work completed _____ 19__

Remarks: