

Name Northeastern Realty Trust

Service No. 166

Address 243 East Street

Lexington, Mass.

Locatic 243 East Street

Kind of Pipe

Size

Size of Main

Remark ~~Renewal~~ - New Service

Com. 9-5-50

Location

Date	Material	Amount	Total	Date	Amount
Jul. 15, '50	Labor	3 45		<i>July 11 '50</i>	<i>Deposited</i>
Jul. 17, '50	Labor	1 30	4 75		
	10% Overhead		48		<i>No Charge</i>
	58' - 3/4" Copper Tubing @.23		13 34	Jul. 17, '50	Labor
	1 - 3/4"C x 1/2" I.W.H. S&W		3 29	22' - 3/4" Copper Tubing @.23	5 06
	1 - 3/4"C x 3/4"C Union (3pts)		1 39	1 - 3/4"C Corp-cock	3 15
	Littlefield Shovel 1 hr. @7.00		7 00	1 - 3/4"C x 3/4"C Curb-cock	3 85
	Trucking 1 hr. @.75		75	1 - Box & Rod	3 35
	Patching 12 x 3		12 00	1 - 1/2" Offset Tail Piece	38
			43 00	1 - 1/2" Straight Tail Piece	38
				Littlefield Shovel 1 1/2 hrs. @7.00	10 50
				Trucking 1 hr. @.75	75
	Labor				<u>31 74</u>

DATE \_\_\_\_\_

# TOWN OF LEXINGTON—BOARD OF PUBLIC WORKS

## WATER DIVISION

The undersigned applies for a supply of water at No. \_\_\_\_\_ St. and hereby agrees to comply with the rules and regulations as now, or at any future time, established by the Board of Selectmen.

Am't. of Estimate \$ \_\_\_\_\_


Owner \_\_\_\_\_

Am't. Paid \$ \_\_\_\_\_

Address \_\_\_\_\_

Builder \_\_\_\_\_

Sketch of Service Here

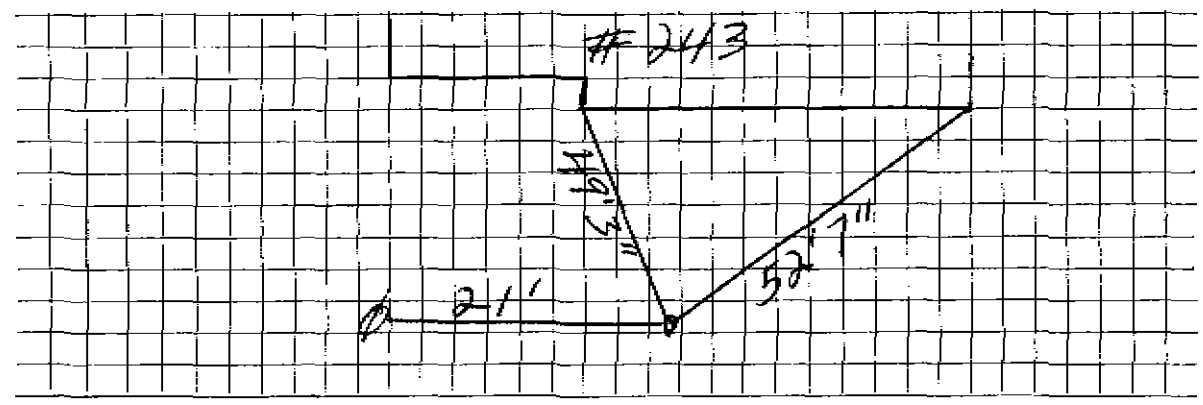

Connection made in \_\_\_\_\_ Street.

Work completed \_\_\_\_\_ 19\_\_

Remarks: